


T. 11 S., R. 2 W., W. M.

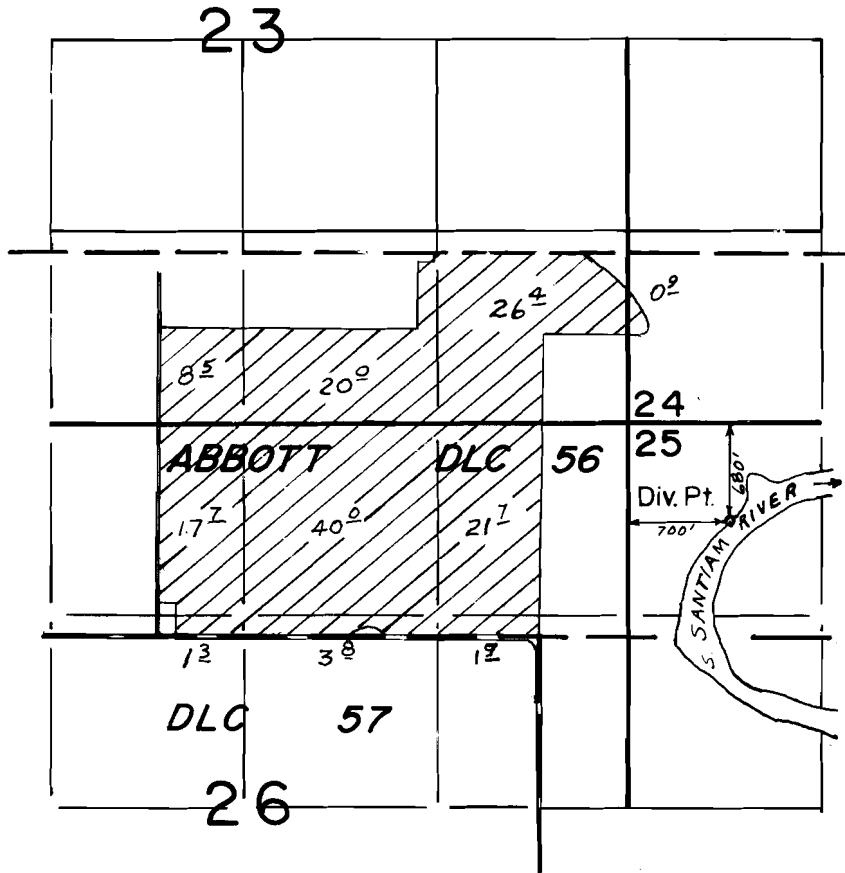

FINAL PROOF SURVEY
UNDER

Application No. 55280... Permit No. 41427....
IN NAME OF

CLAIR HULL

Surveyed Sept..7... 19.78, by J.S..DONALDSON