


T.11S., R.2W., W.M.

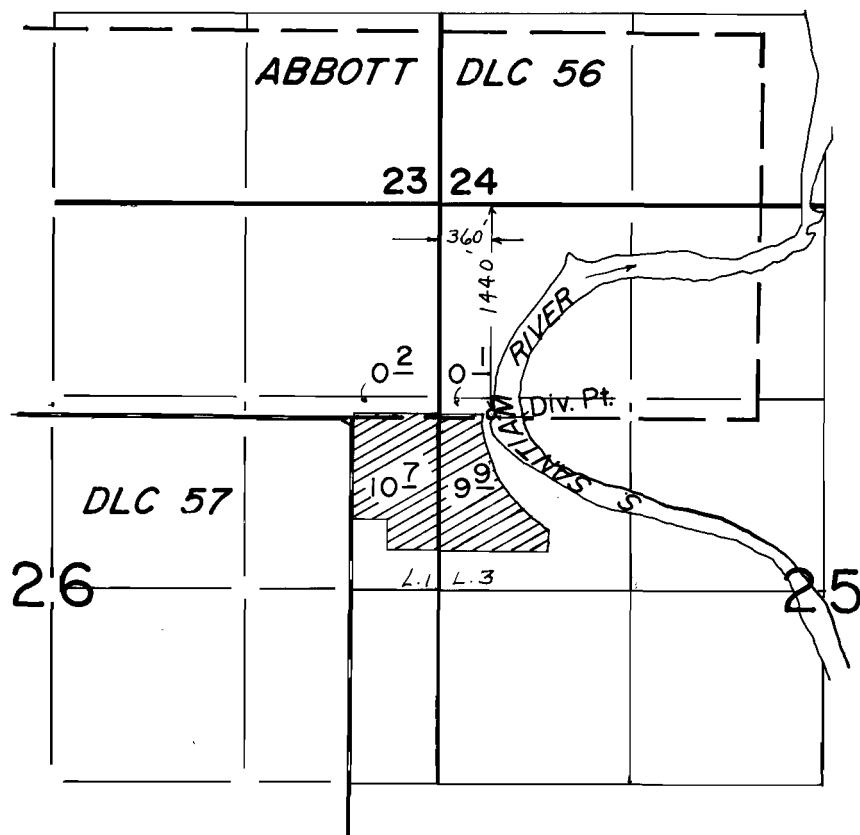

FINAL PROOF SURVEY
UNDER

Application No. 55281..... Permit No. 41428....
IN NAME OF

.....
CLAIR HULL
.....

Surveyed Sept. 7, 1978, by J.S. DONALDSON