


T.11S., R.2W., W.M.

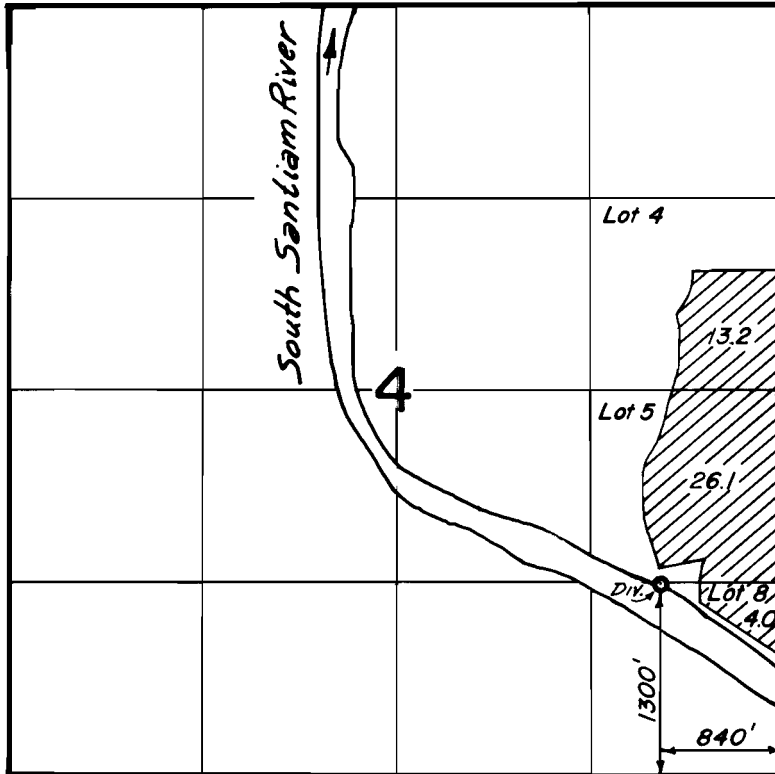

FINAL PROOF SURVEY
UNDER

Application No. 55181 Permit No. 41607
IN NAME OF
SHUMAKER FARMS

Surveyed APR. 17, 1978, by S. APPLGATE