



I, A. N. GOULD of Coquille, Oregon do hereby certify that this map was made from notes taken during an actual survey made by me on November 9, 1920, and that it correctly represents the works described in the accompanying application together with the location of streams and other ditches in the immediate vicinity

A. N. Gould.
Surveyor.

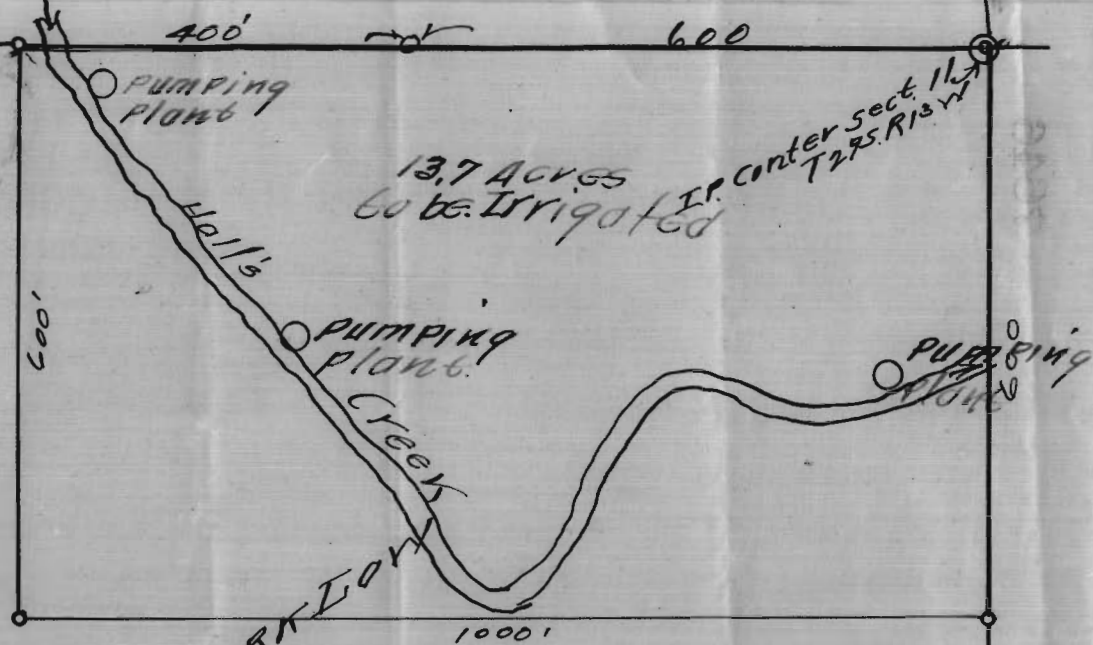

OFFICE OF STATE ENGINEER
RECEIVED
DEC 8 1920
SALEM, OREGON

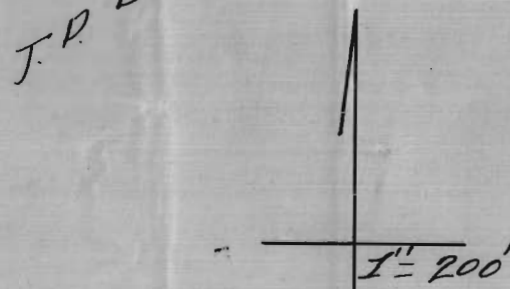

Application No. 7646
Permit No. 4869

2070