


T.9S. R.1E., W.M.

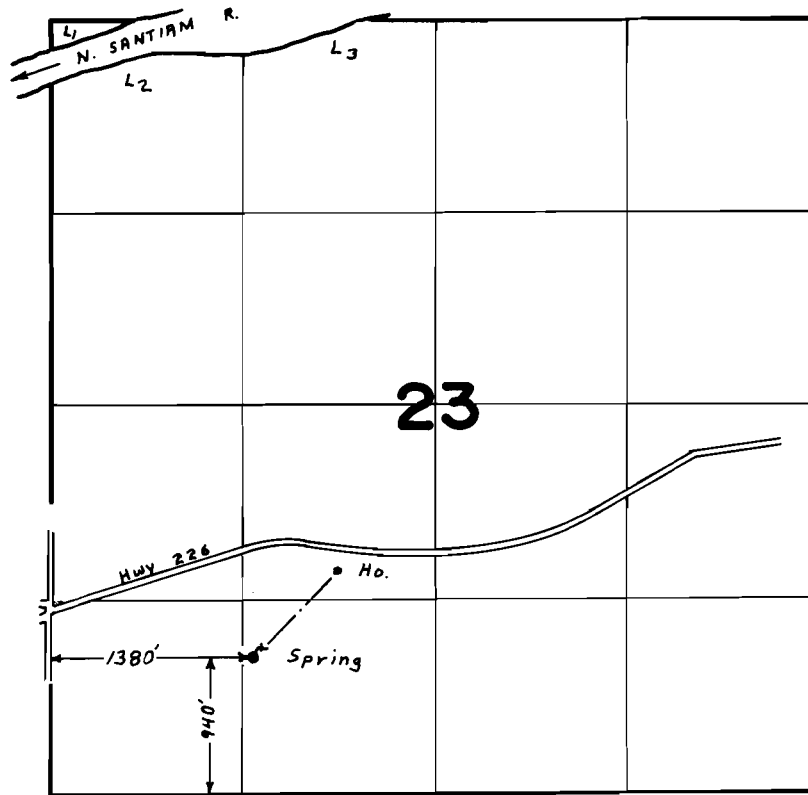

FINAL PROOF SURVEY UNDER

Application No. 54807... Permit No. 41118
IN NAME OF

HOMER O. MITCHELL

Surveyed APR. 11... 1978, by S.P. APPLGATE