


T. 4 S. R. 1 W. W. M.

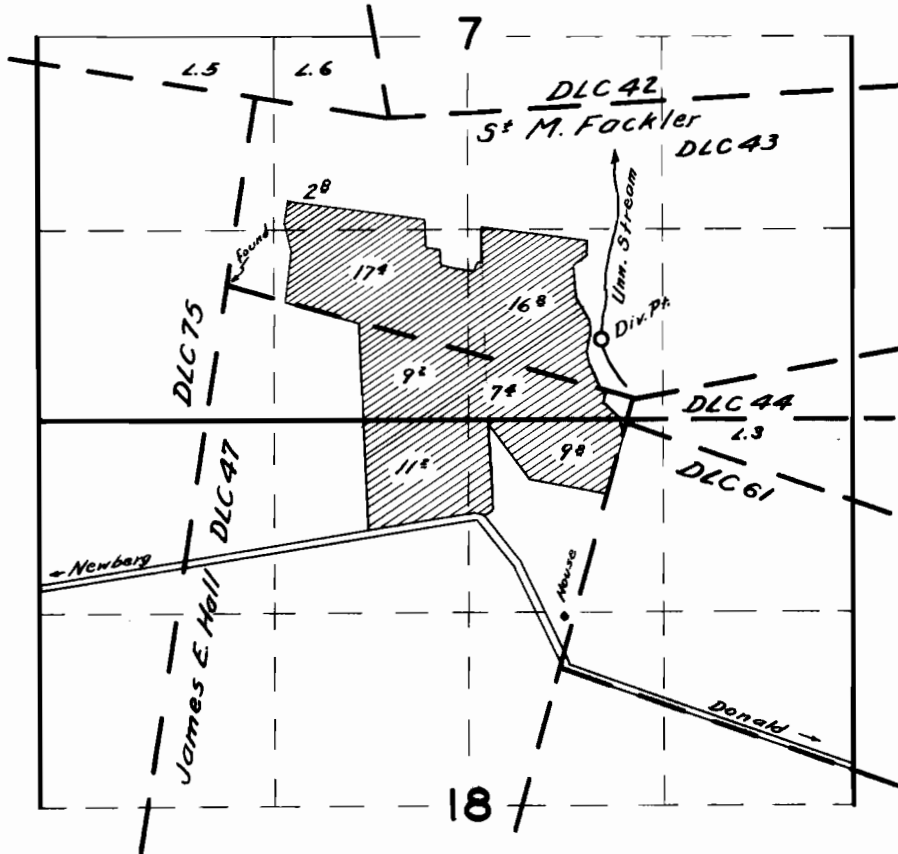

FINAL PROOF SURVEY

UNDER

Application No. 23893. Permit No. 18896

IN NAME OF

J. A. Bush

Surveyed Aug. 17, 1956, by C. O. Bartels


RECEIVED

JUN 17 1977

WATER RESOURCES DEPT.
SALEM, OREGON

T. 4 S. R. 1 W. W. M.

willy part

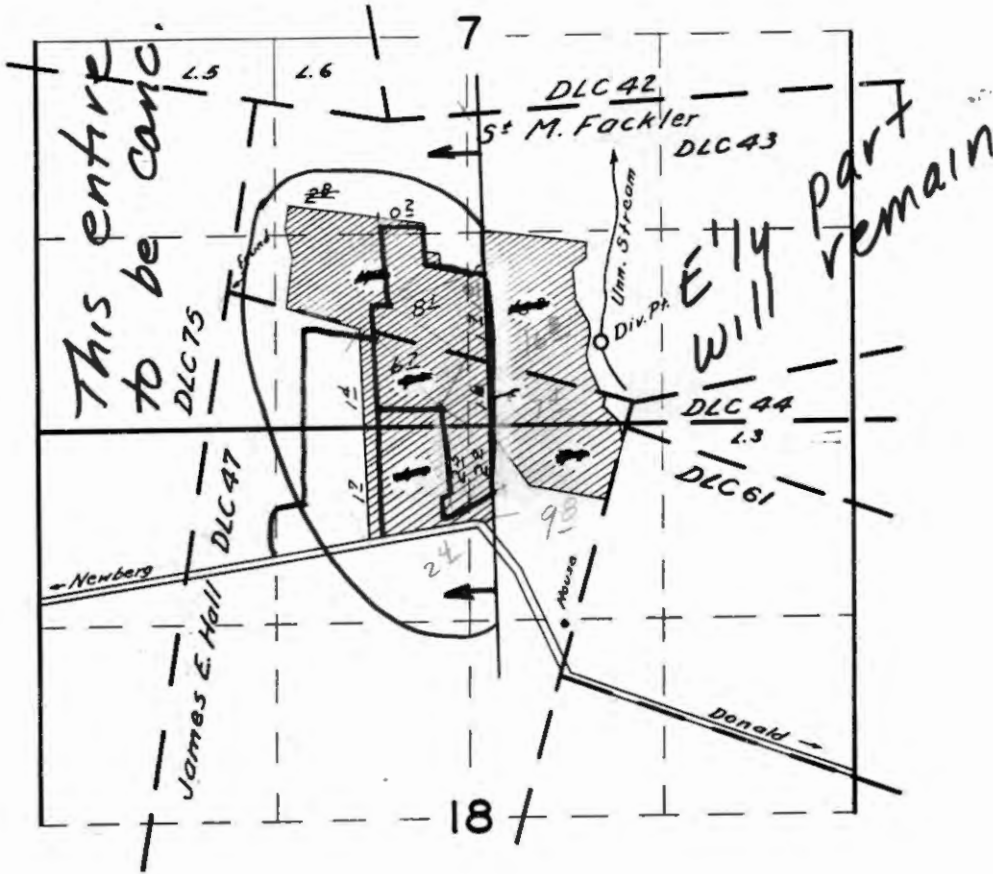

This entire to be conc.

Ety will part remain

FINAL PROOF SURVEY
UNDER

Application No. 23893. Permit No. 18896
IN NAME OF

J. A. Bush

Surveyed Aug. 17, 1956., by C. O. Bartels

T. 4 S. R. 1 W. W. M.



FINAL PROOF SURVEY

UNDER

Application No. 23893. Permit No. 18896..

IN NAME OF

J. A. Bush

Surveyed Aug. 17. 1956., by C. O. Bartels..