


T.4S. R.1W.W.M.

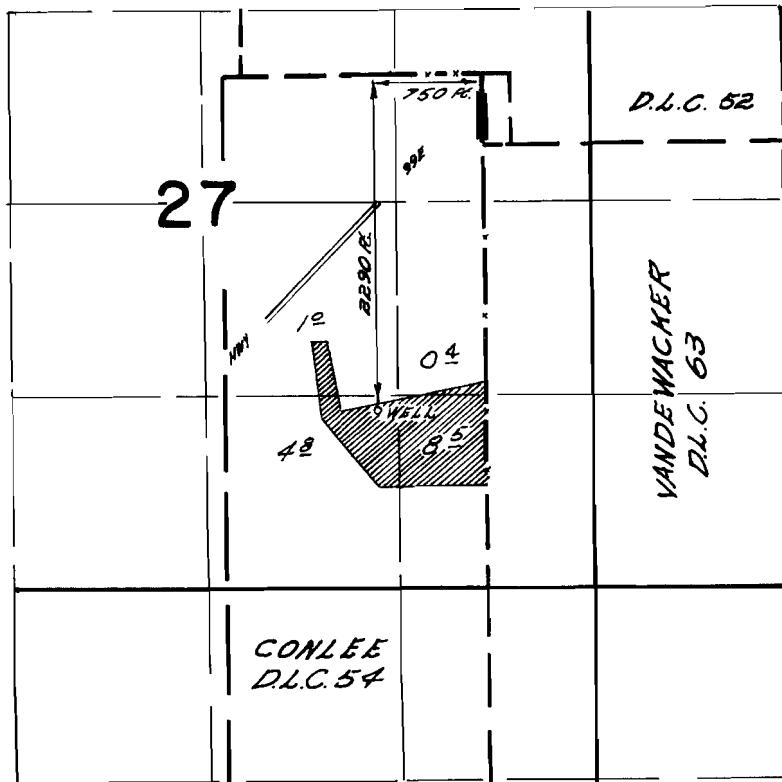

FINAL PROOF SURVEY UNDER

Application No. *G-3022* Permit No. *G-2811*
IN NAME OF

JOHN M. FREDERICK

Surveyed *MAY 10*, 1968, by *M.O. Ruppert*