


# T.10S. R.3W., W.M.

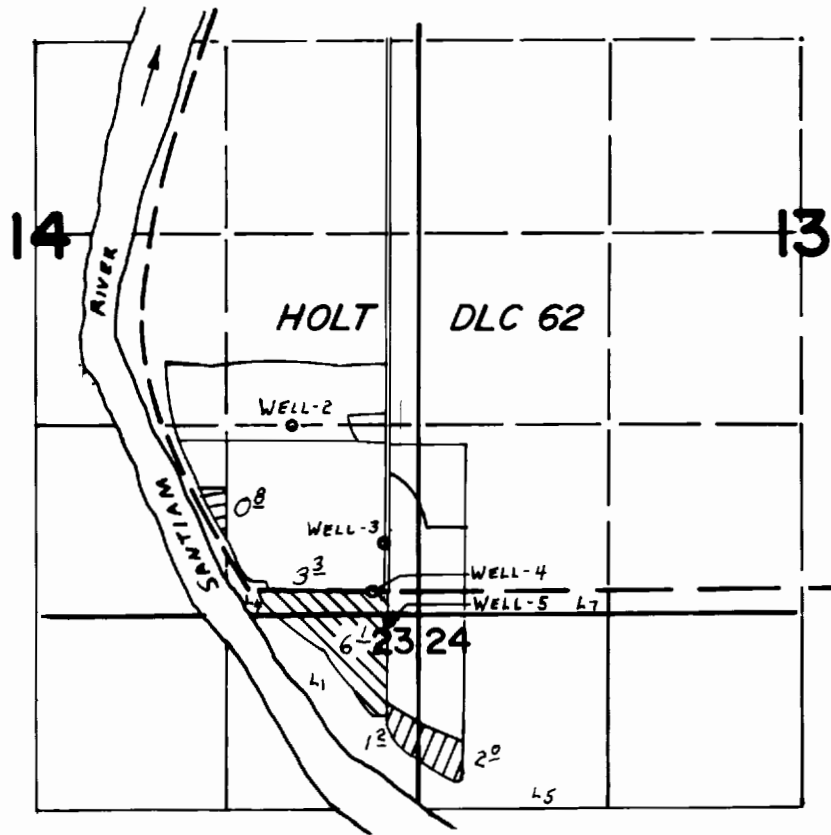

WELL-3 500' N. & 230' W. } ALL FROM S.E. COR. SEC. 14  
 WELL-4 160' N. & 320' W. }  
 WELL-5 50' S. & 200' W. }

## FINAL PROOF SURVEY UNDER

Application No. G-7705... Permit No. G-7161...  
IN NAME OF

HOWARD A. SCHELSKE

Surveyed MAY 24 1978, by S. P. APPLGATE