


T.5S. R.2W., W.M.

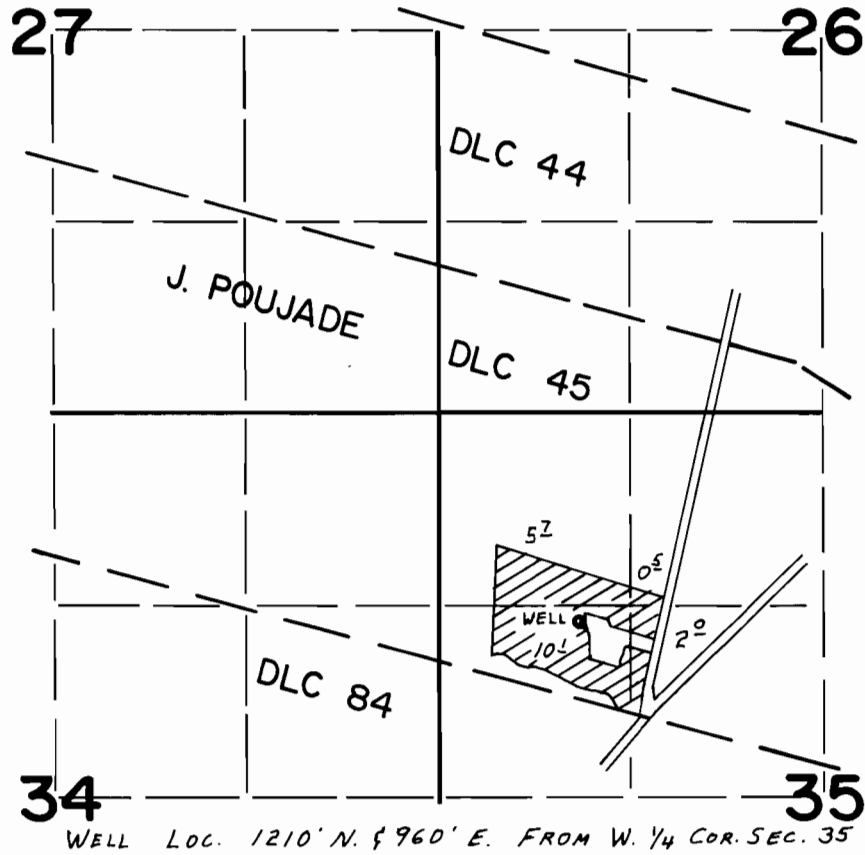

FINAL PROOF SURVEY UNDER

Application No. G-7708. Permit No. G-7266.
IN NAME OF

TIMOFEY KALUGIN

Surveyed SEP. 28. 1978, by S. P. APPLIGATE