


T.6S.R.3W. W.M.

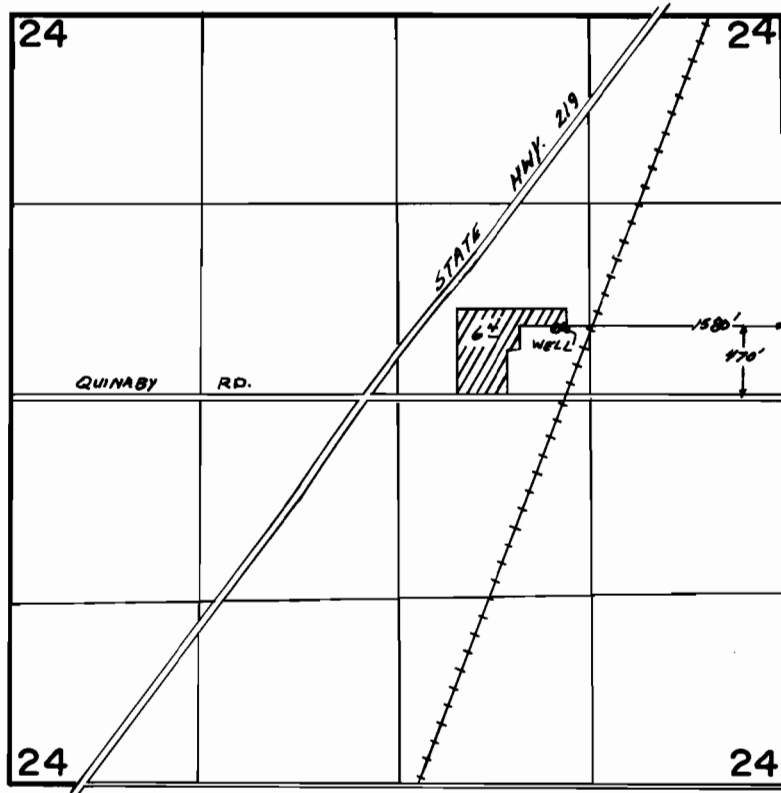

FINAL PROOF SURVEY UNDER

Application No. G-7918.. Permit No. G-7310..
IN NAME OF

.....DOLORES..ZIELINSKI.....

Surveyed Oct...10.. 1978, by J.S.Donaldson..