


T.7S. R.6W. W.M.

SEC. 1

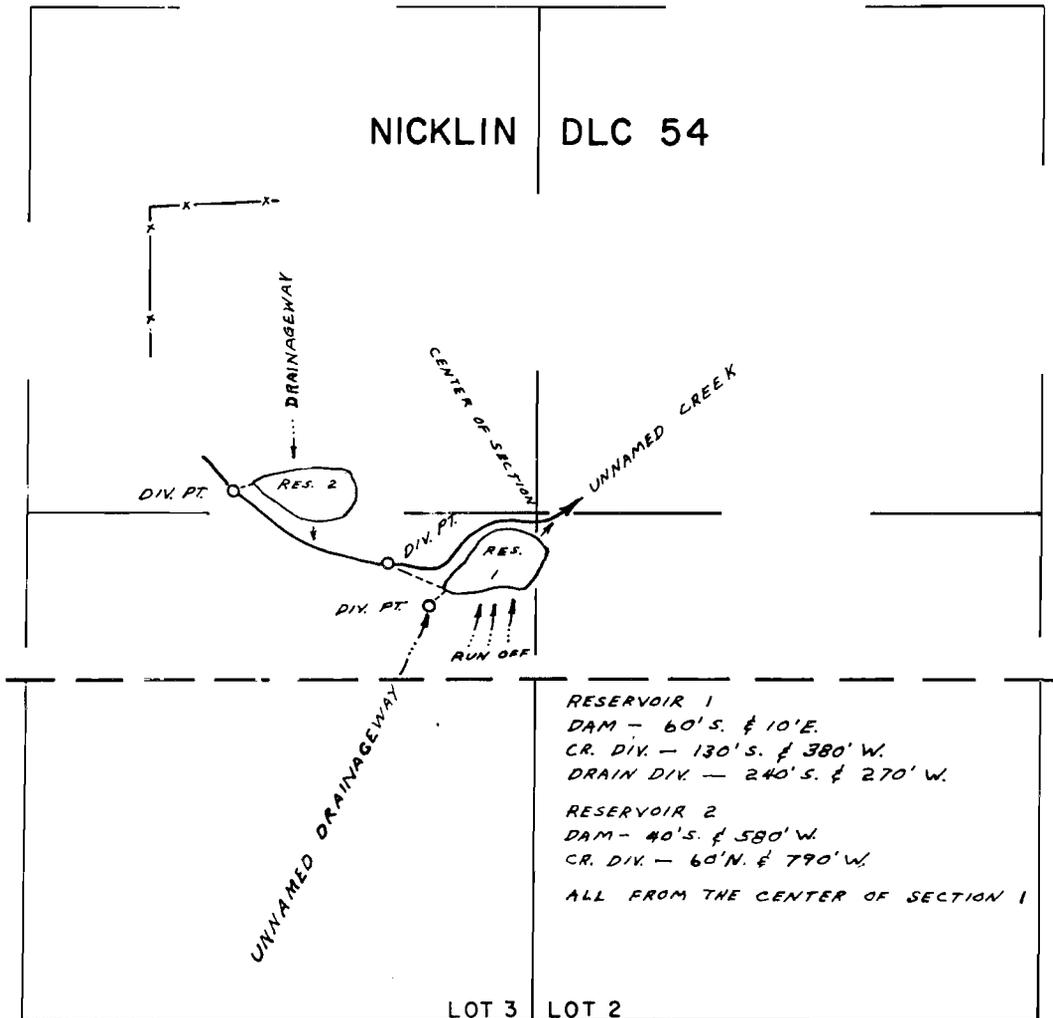

SCALE 1"=500

FINAL PROOF SURVEY

UNDER

R- 51347

51348

R- 52916

R- 6217

38763

R- 6402

Application No. 52917..... Permit No. 40107.....

IN NAME OF

.....ROBERT E. BRINKER.....

Surveyed APR. 14. 1977., by L.H. NUNN.....