


T.5N.R.28E.W.M.

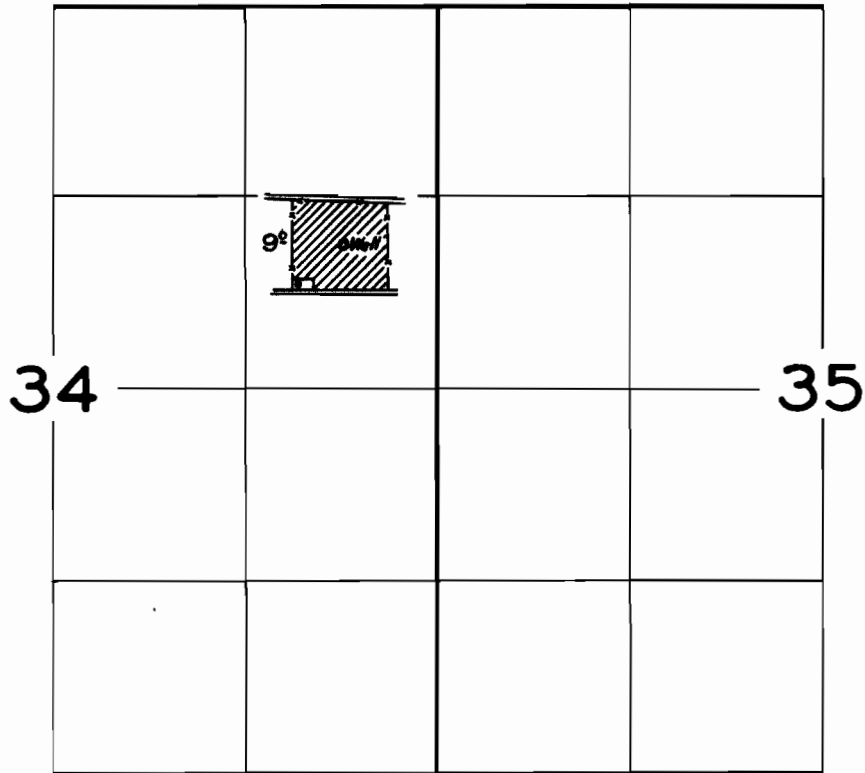

**FINAL PROOF SURVEY**  
UNDER

Application No. G-1438 Permit No. G-1314.....  
IN NAME OF

S. W. & FLORENCE STEWART

Surveyed June 12 1962, by A. Jackson