


T.8S. R.16E. W.M.

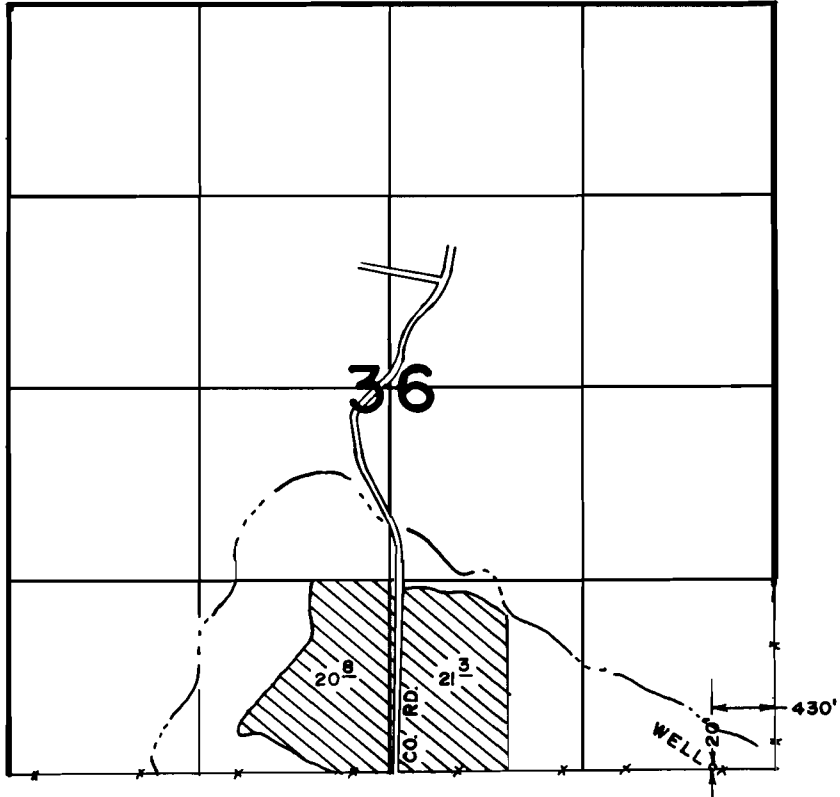

**FINAL PROOF SURVEY**  
UNDER

Application No. G-6855 Permit No. G-6394.....  
IN NAME OF

FRANK McNAMEE

Surveyed DEC. 16 1980., by L.H. NUNN.....

*CERT. # 49956*