


T. 5 S. R. 6 W. W. M.

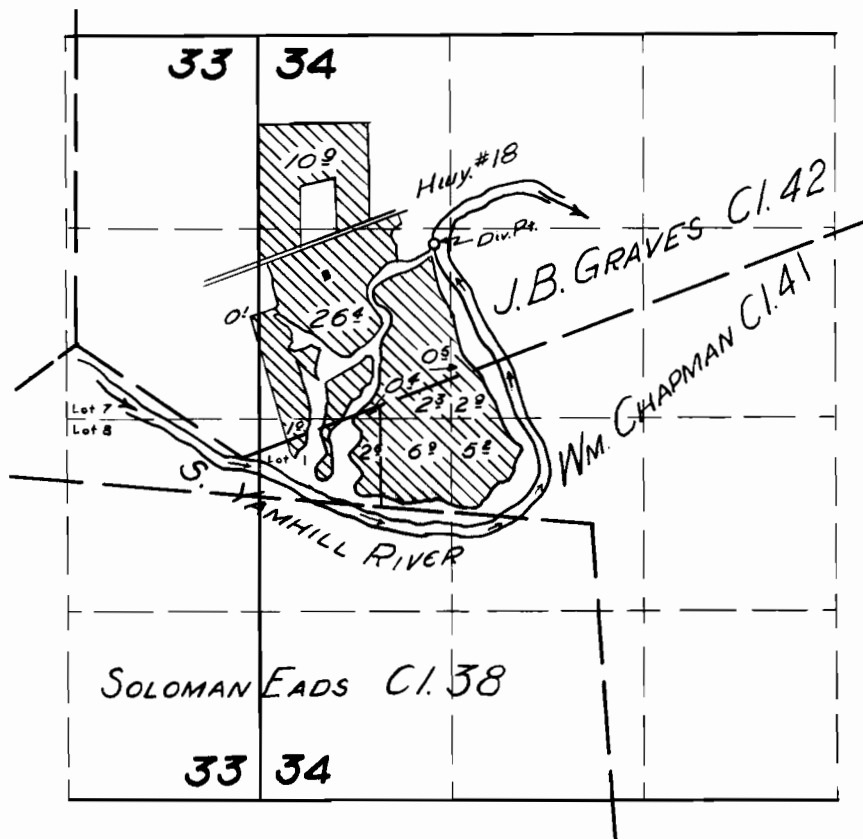

FINAL PROOF SURVEY
UNDER

Application No. 28261 Permit No. 22222
IN NAME OF

OTTO W. HEIDER

Surveyed 8 Mar. 1956, by *R. Bluhm*