


T4S, R3W WM

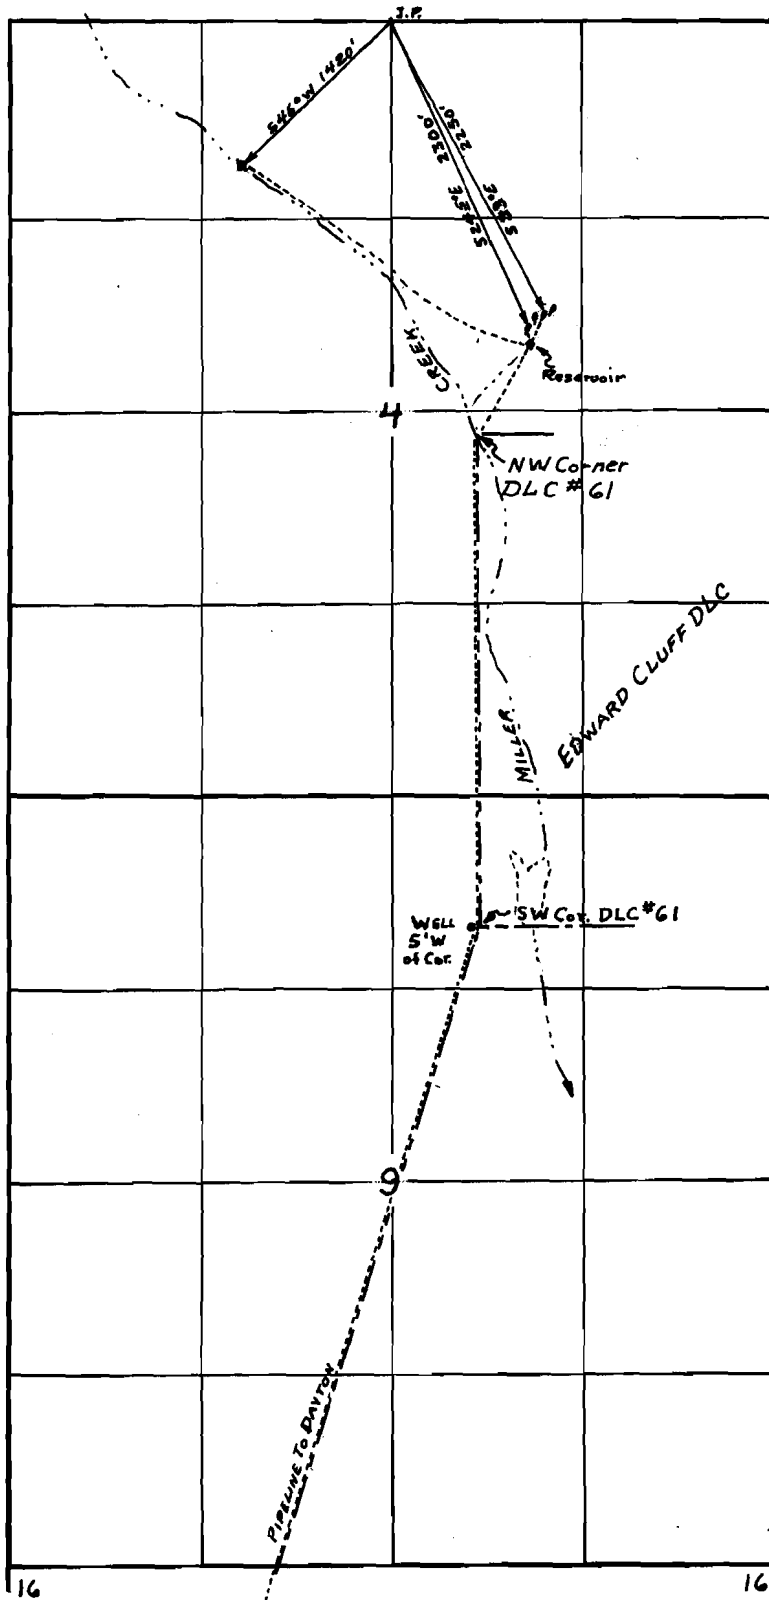


Application No. 34218
Permit No. 26950

CITY OF DAYTON MUNICIPAL WATER SUPPLY

Application No. 6-1819 + 6-1820

Permit No. 6-1663 + 6-1664 DRG 1 OF 2

T4S, R3W WM

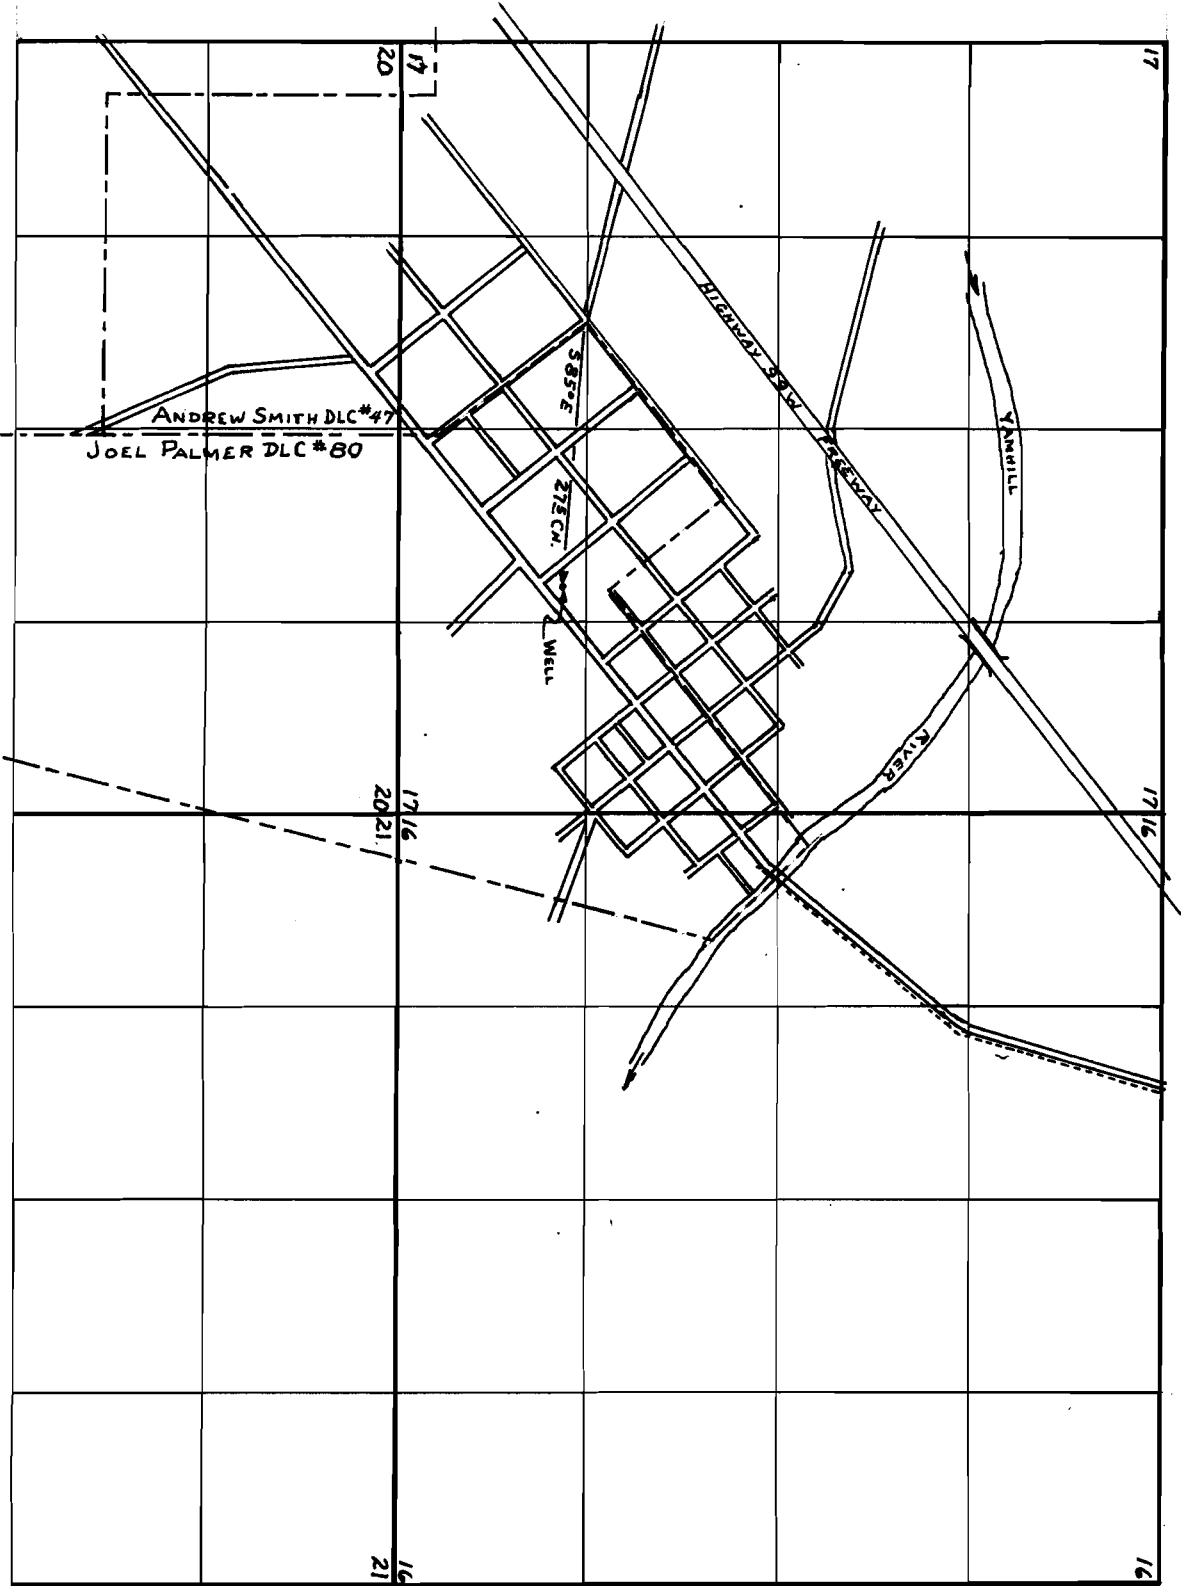

Application No. 34218
Permit No. 26950

CITY OF DAYTON MUNICIPAL WATER SUPPLY
Application No. G-1819 & G-1820
Permit No. G-1663 & G-1664

DRG 2052