


T. 36 S. R. 14 W. W.M.

Sec. 29

SE 1/4

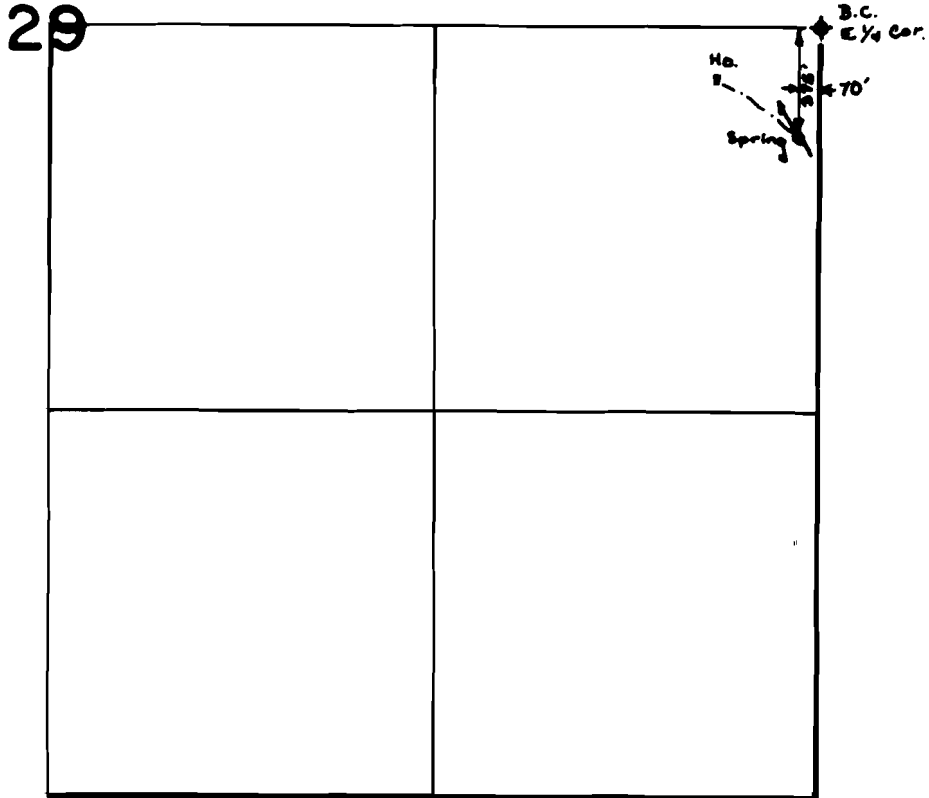

SCALE: 8" = 1 mile

FINAL PROOF SURVEY
UNDER

Application No. 53371 Permit No. 39594
IN NAME OF

NORMAN KRAMBEAL

Surveyed June 5, 1978, by D. Sparks