


T.40S. R.13W. W.M.

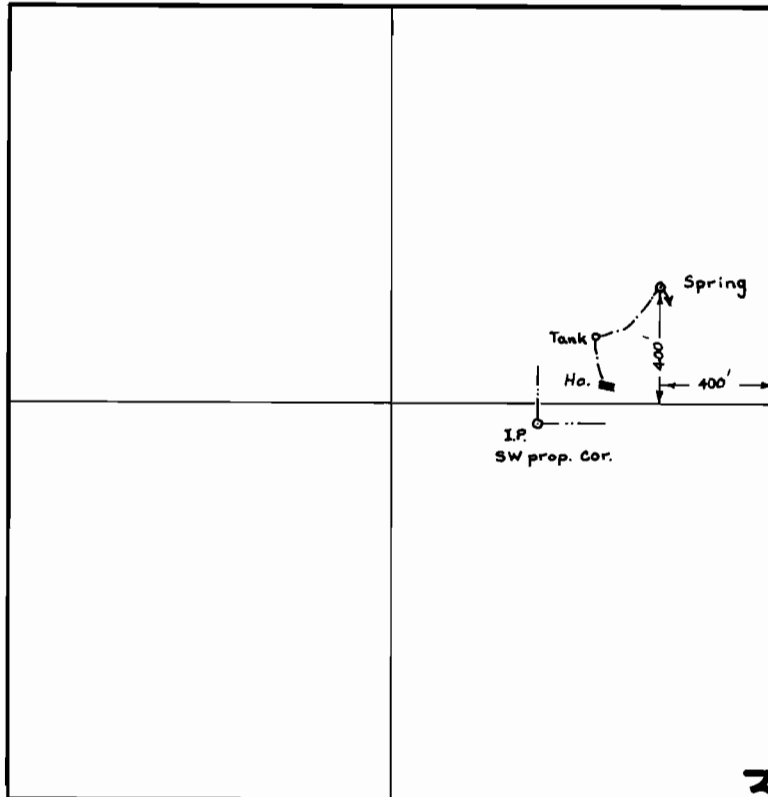

33

SCALE: 1" = 660'

FINAL PROOF SURVEY
UNDER

Application No. 54234 Permit No. 40626
IN NAME OF

GEORGE B. CUMMINS

Surveyed July 17, 1978, by D.W. Sparks

280