T41 SR13WWM

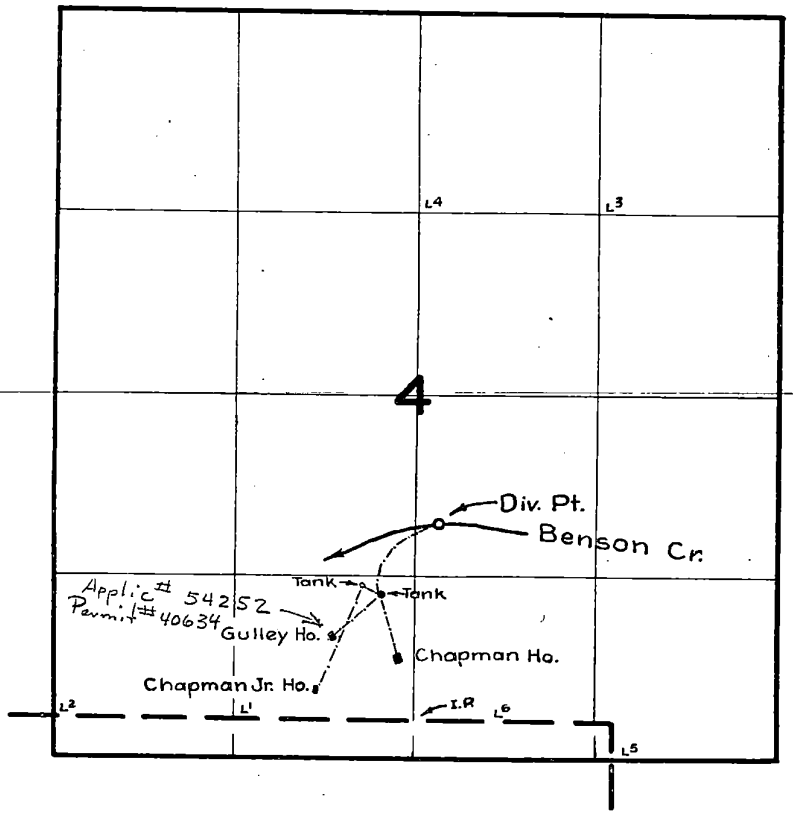

FINAL PROOF SURVEY
UNDER

Application No. 24562 Permit No. 19364
IN NAME OF

.....

Surveyed Mar. 19 1958, by M. Bish

1958-A