


T.36 S. R.14 W. W.M.

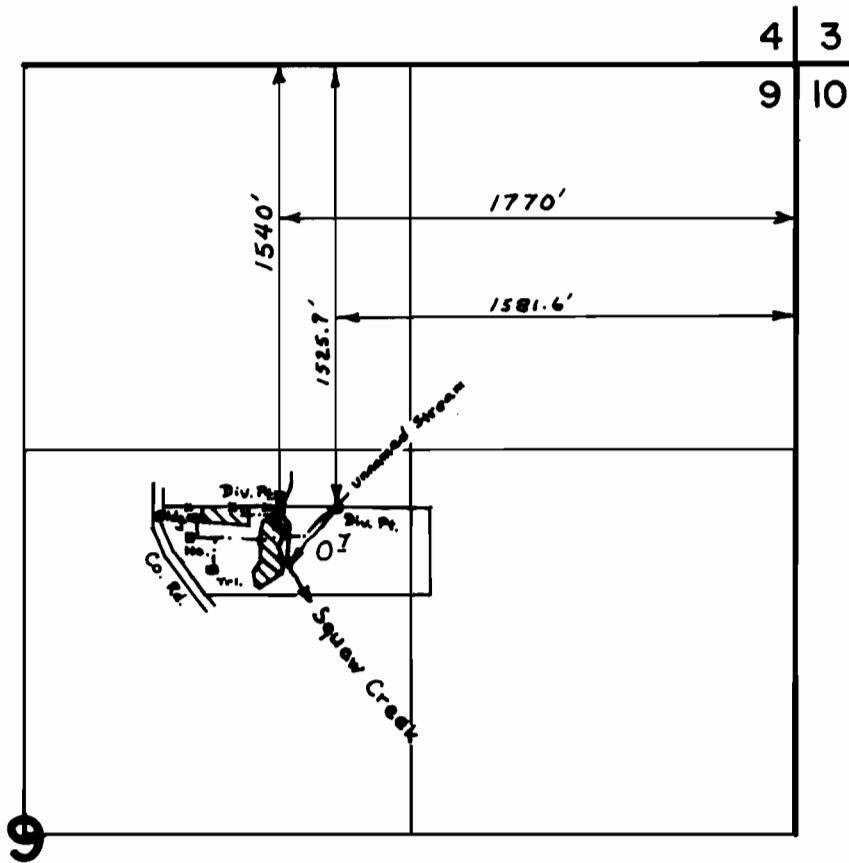

SCALE: 8" = 1 mile

FINAL PROOF SURVEY
UNDER

Application No. 54686 Permit No. 41029
54687 Permit No. 41030
IN NAME OF

PAUL & VERNA McVEY

Surveyed June 5-6 1978, by D. Sparks.....