


T.36S. R.14W. W.M.

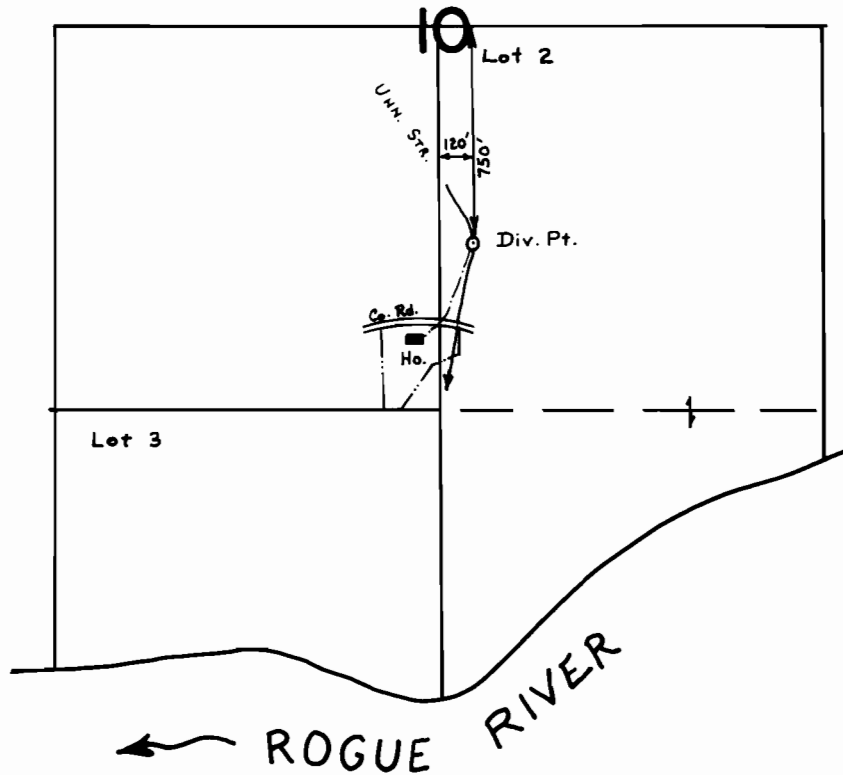

SCALE: 1" = 660'

**FINAL PROOF SURVEY**  
UNDER

Application No. 54819 Permit No. 41127  
IN NAME OF

**PATRICIA & ARTHUR LEWMAN**

Surveyed June 6, 1978, by D. W. Sparks