

**WATER RIGHTS LOCATION
for IRENE YOUNG**

SECTION 11, T40S, R14W W.M.

Curry County, Oregon


Scale: 1" = 100'

9/76

**REGISTERED
PROFESSIONAL
LAND SURVEYOR**

Donald Cormack

**OREGON
AUGUST 22, 1975
DONALD F. CORMACK
1027**

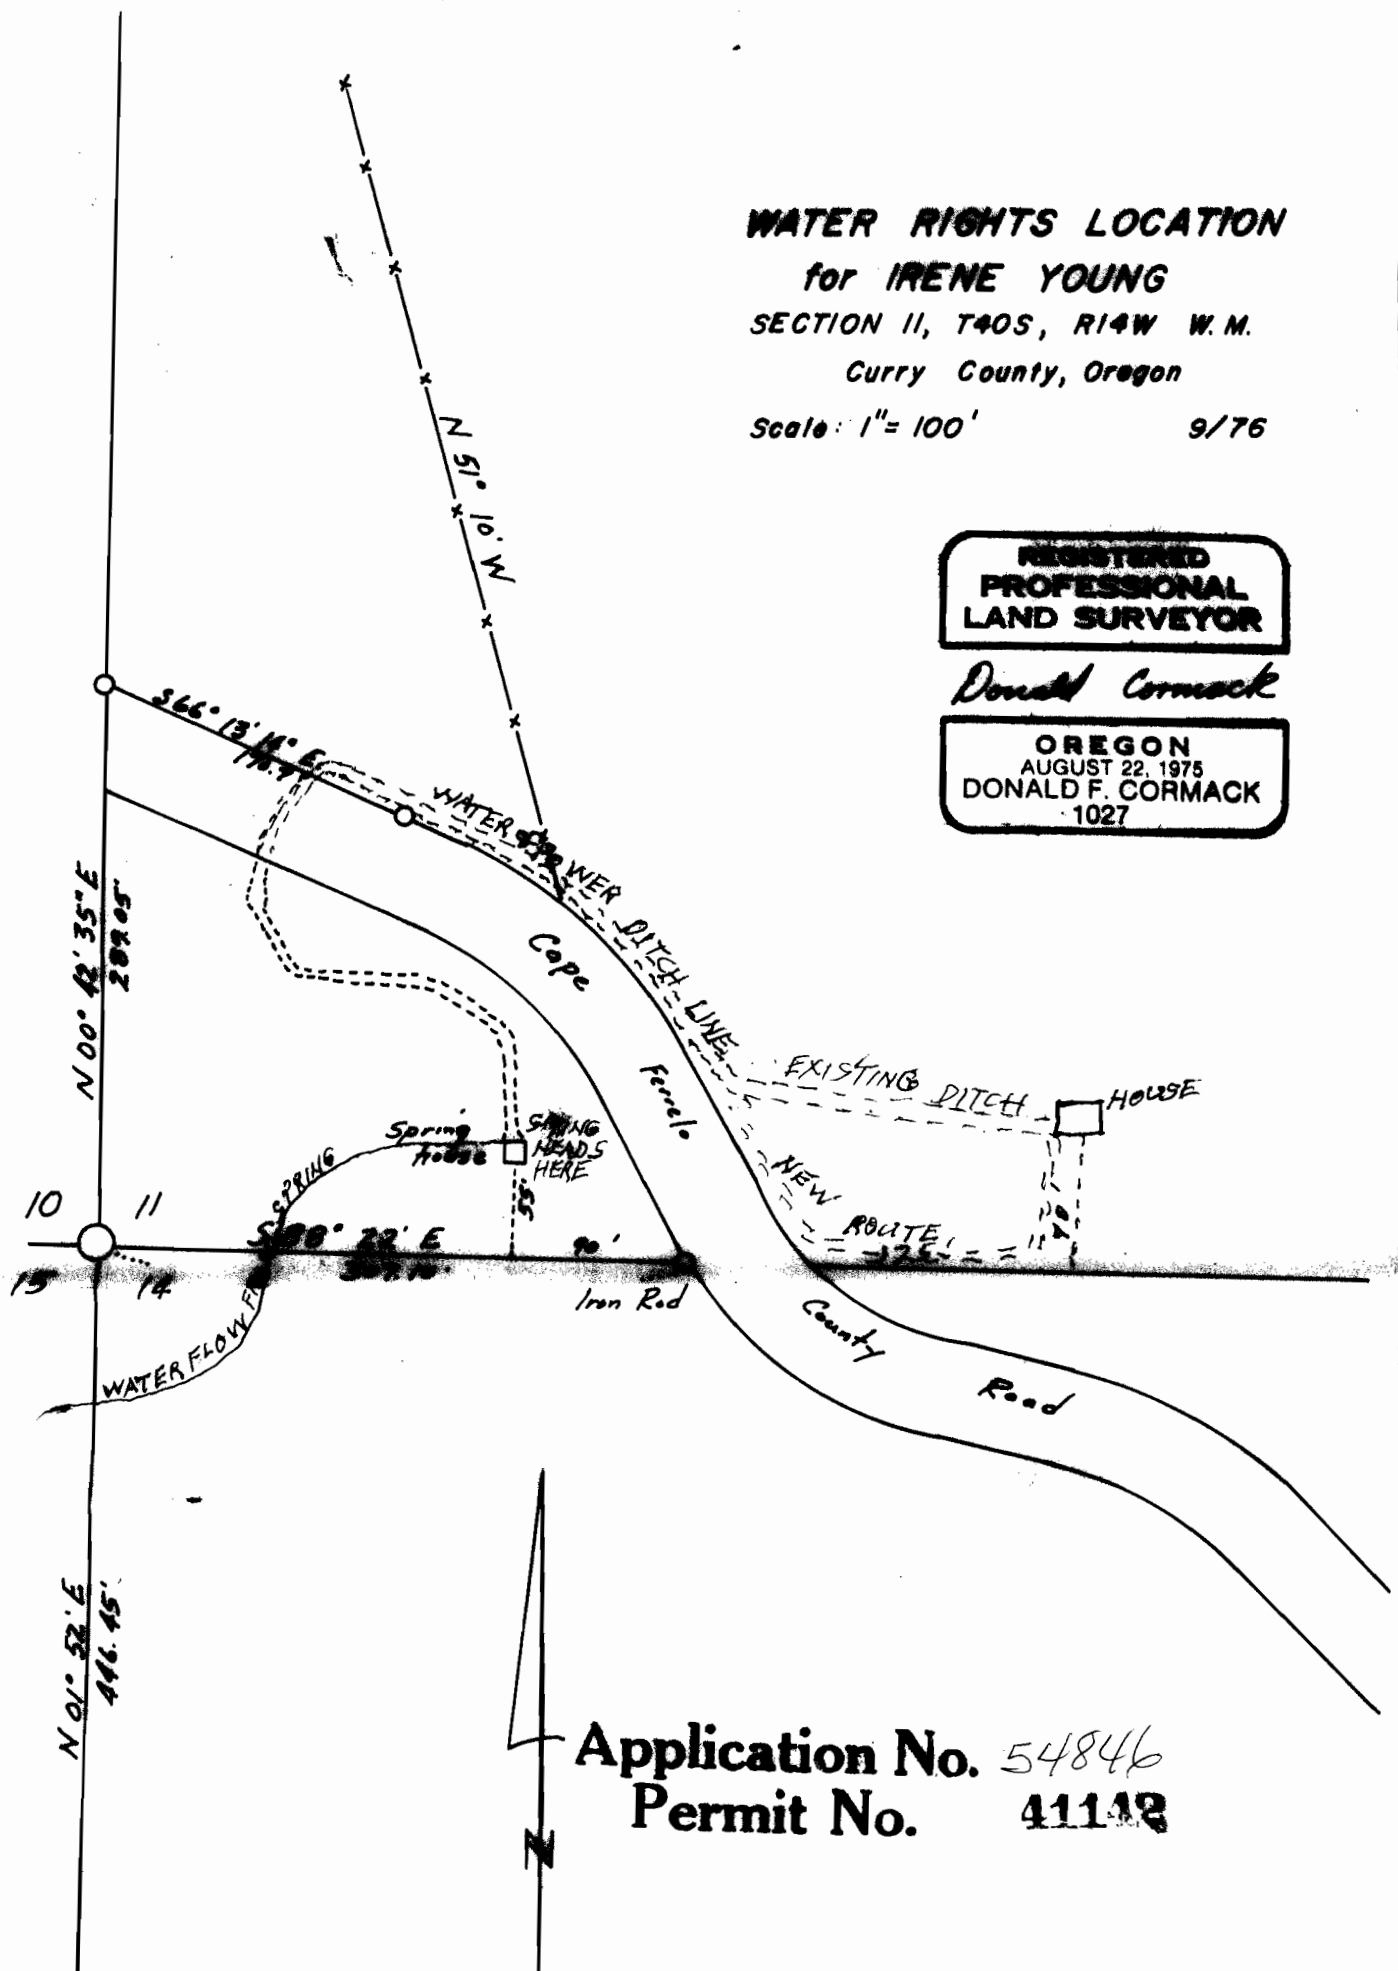

**Application No. 54846
Permit No. 41142**