


T.40S. R.14W. W.M.

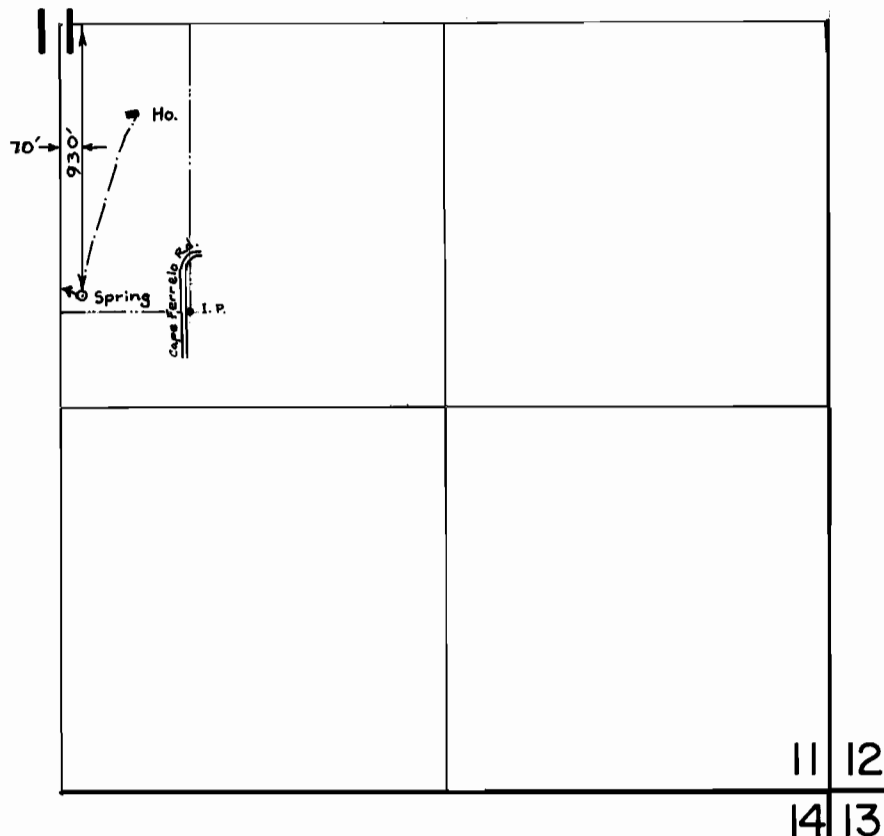

SCALE: 1" = 660'

FINAL PROOF SURVEY
UNDER

Application No. 54951 Permit No. 41243
IN NAME OF

GERALD H. & FREEDA MOORE

Surveyed July 17, 1978, by D. W. Sparks