


T.36 S. R.14 W. W.M.

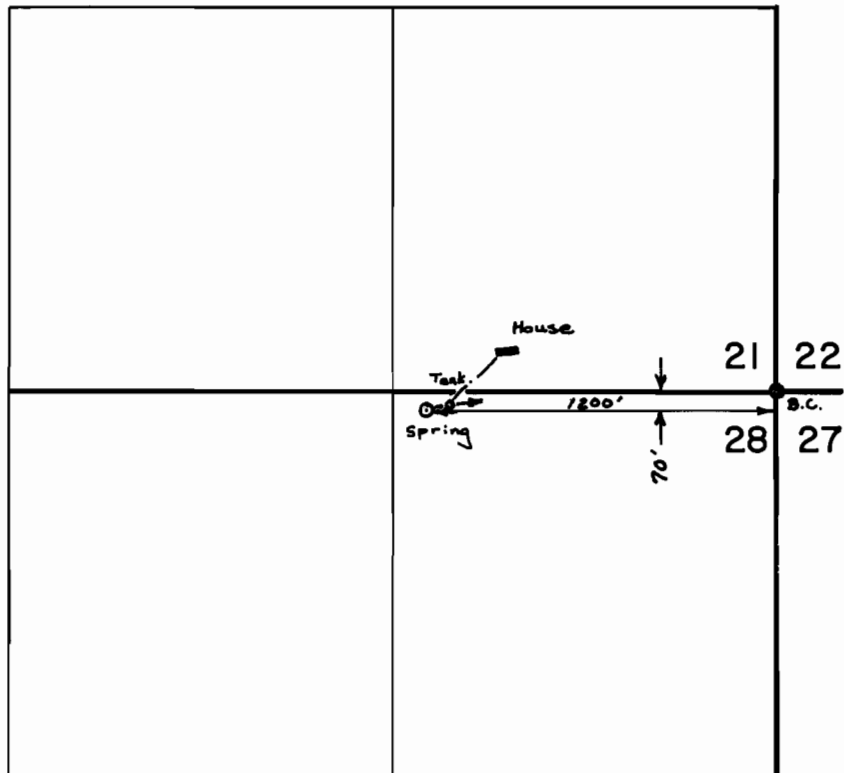

SCALE : 8" = 1 mile

FINAL PROOF SURVEY
UNDER

Application No. 55046 Permit No. 41286
IN NAME OF

ROBERT L. HATCH

Surveyed June 5, 1978, by D. Sparks