


T.40S. R.14W. W.M.

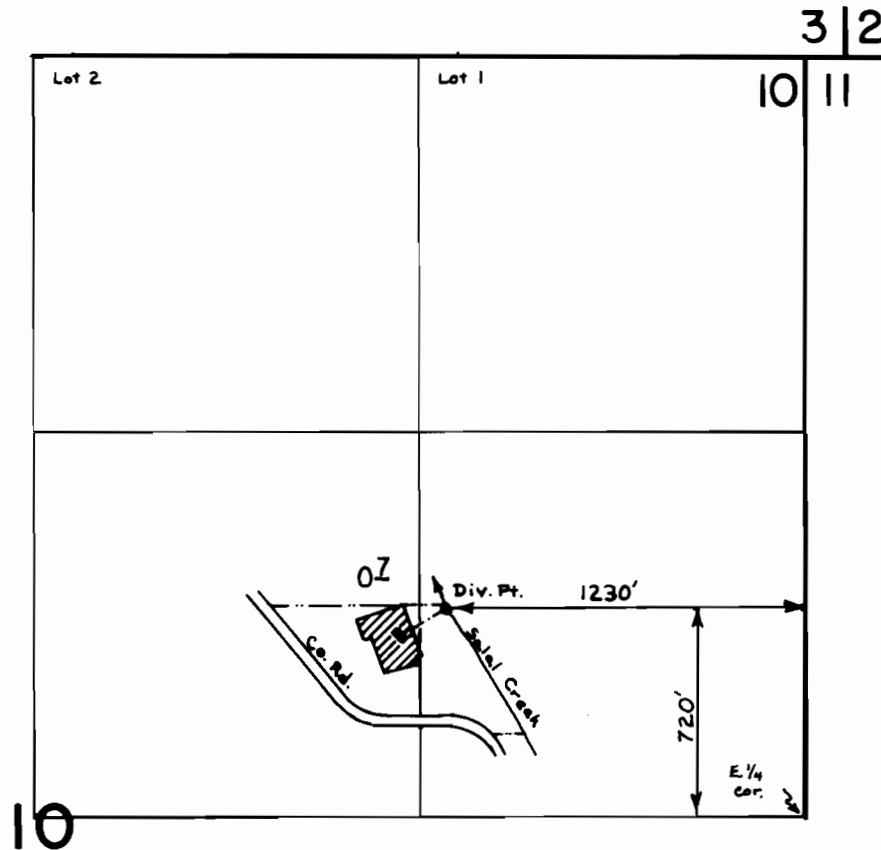

SCALE: 1" = 660'

FINAL PROOF SURVEY
UNDER

Application No. 55124 Permit No. 41391
IN NAME OF

WILLARD M. HAYNE

Surveyed July 17, 1978, by D.W. Sparks