


T16S. R2E. WM.

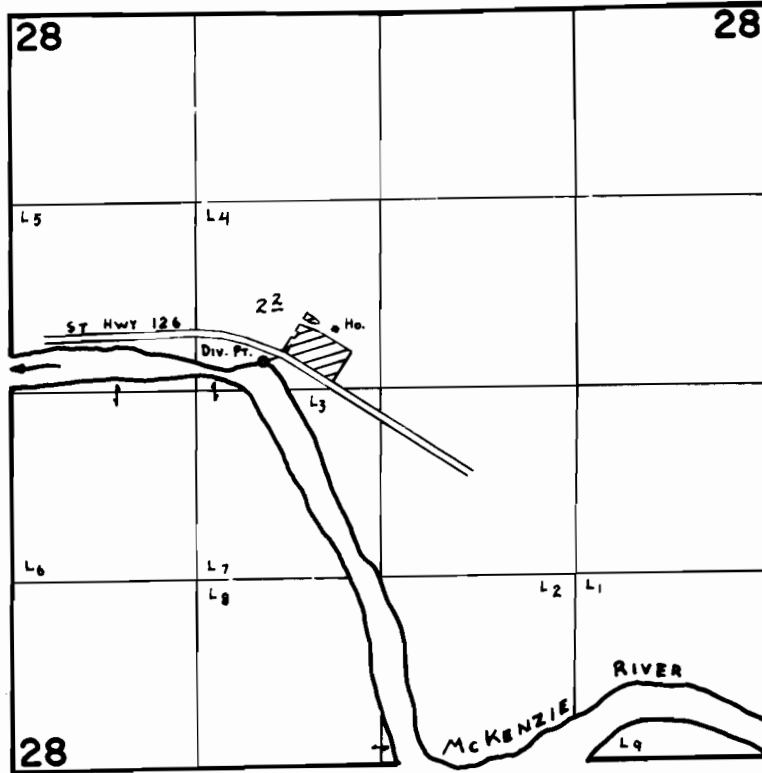

Div. Pt. Loc: 190' N. & 800' W. fr. C-1/4 Cor. SEC. 28.

FINAL PROOF SURVEY UNDER

Application No. 49667 Permit No. 37188
IN NAME OF

ROY L. & DORIS A. RICHARDSON

Surveyed MAY 25 1978, by C. L. HUGHES