


T16S. R7W. WM.

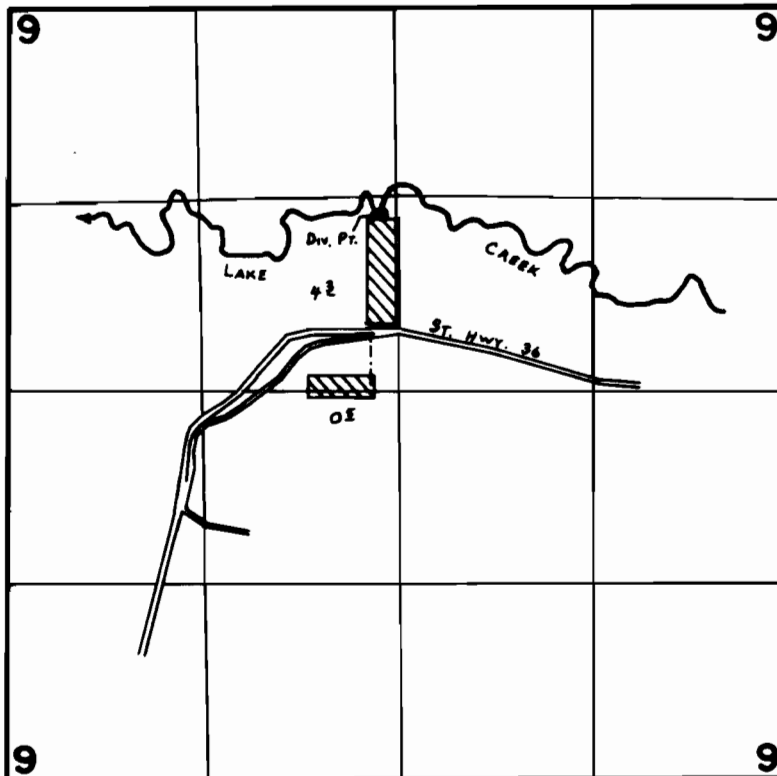

Div. Pt. Loc: 1410'S. & 2550'E. fr. N.W. CoA. Sec. 9.

FINAL PROOF SURVEY UNDER

Application No. 53570 Permit No. 38214
IN NAME OF

TRIANGLE LAKE SCHOOL

Surveyed JUNE 13, 1978, by C. L. HUGHES