


T17S. RIW. WM.

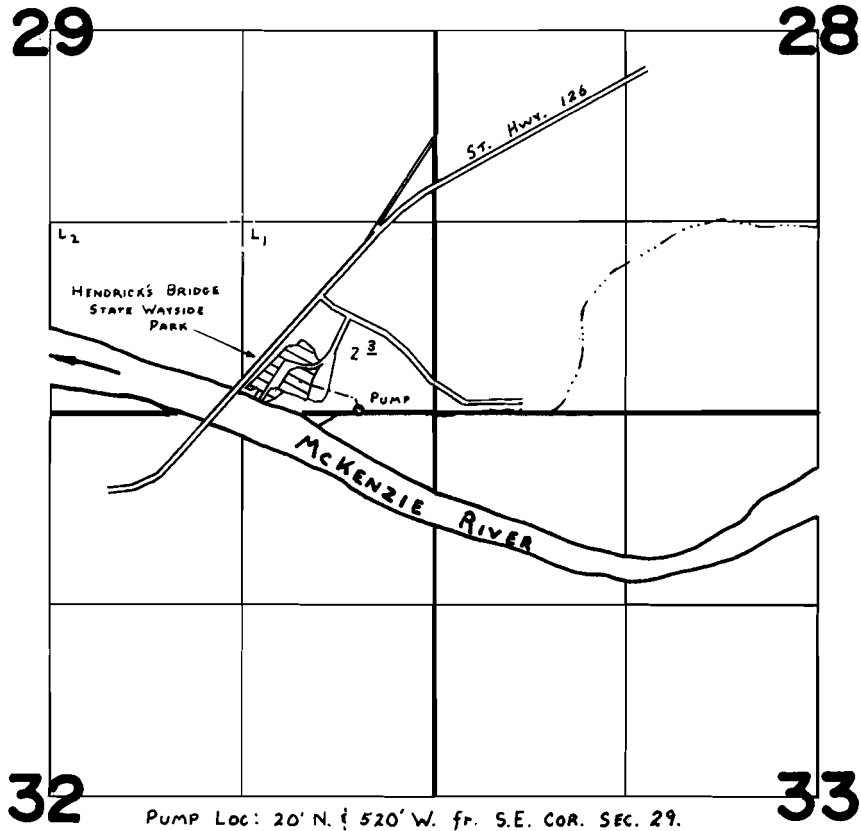

FINAL PROOF SURVEY UNDER

Application No. 53131 Permit No. 38608
IN NAME OF
OREGON STATE HIGHWAY DIVISION
PARKS & RECREATION BRANCH

Surveyed JULY 18, 1978, by C. L. HUGHES.