


T18S. RIW. WM.

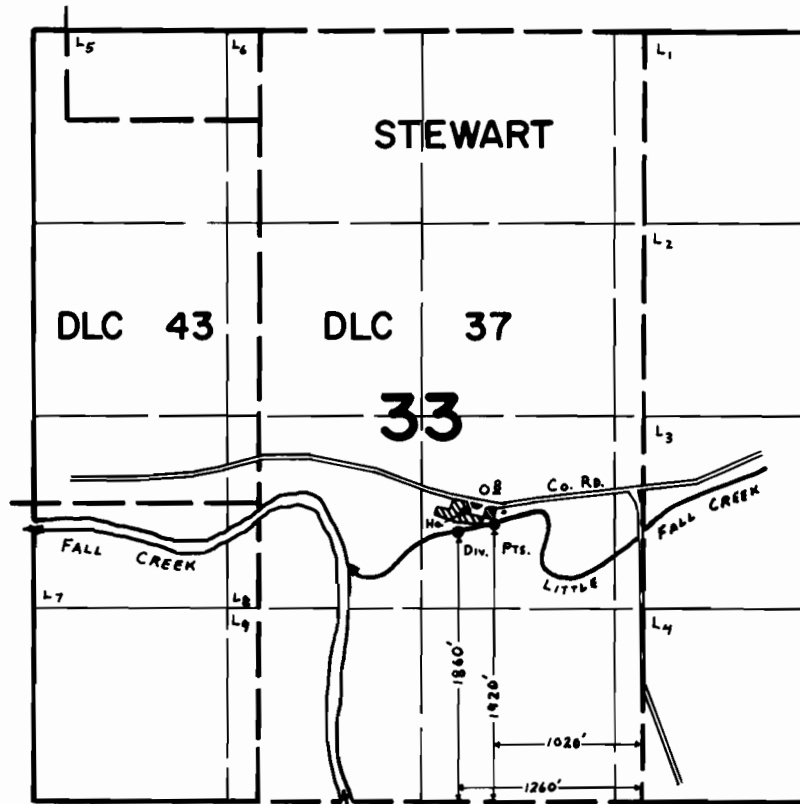

FINAL PROOF SURVEY
UNDER

Application No. 52561 Permit No. 38625
IN NAME OF

CHARLES W. & ANNA MULLINS

Surveyed JULY 19 1978, by C. L. HUGHES