


T20S. R2W. WM.

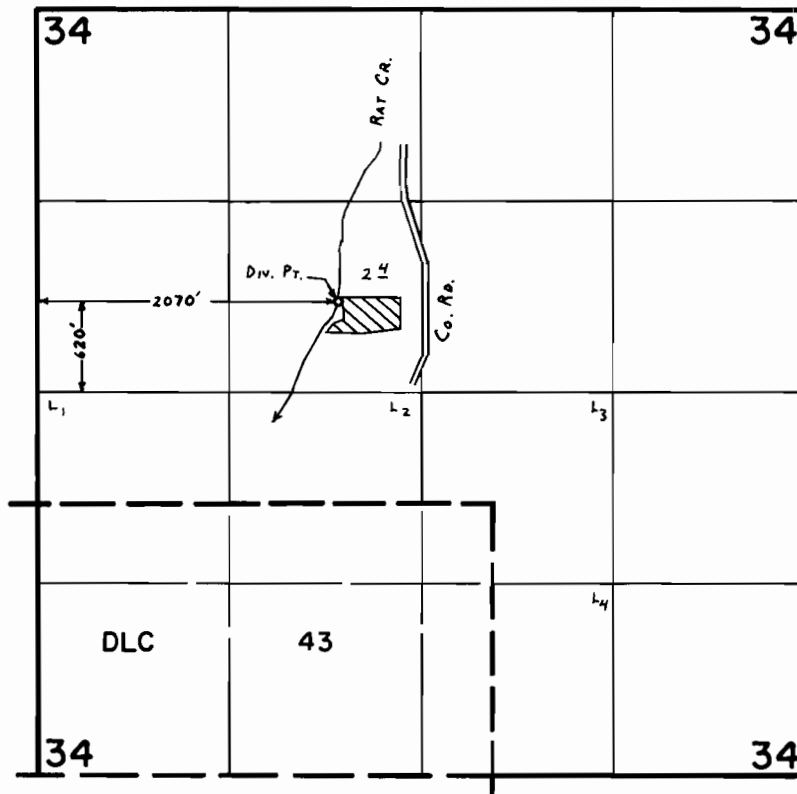

FINAL PROOF SURVEY UNDER

Application No. 52031... Permit No. 39215...
IN NAME OF

MARION E. CRISP

Surveyed JULY 20 1978, by C. L. HUGHES