


RECEIVED

FEB 27 1975

STATE ENGINEER  
SALEM, OREGON

T.18S., R.5W., W.M.

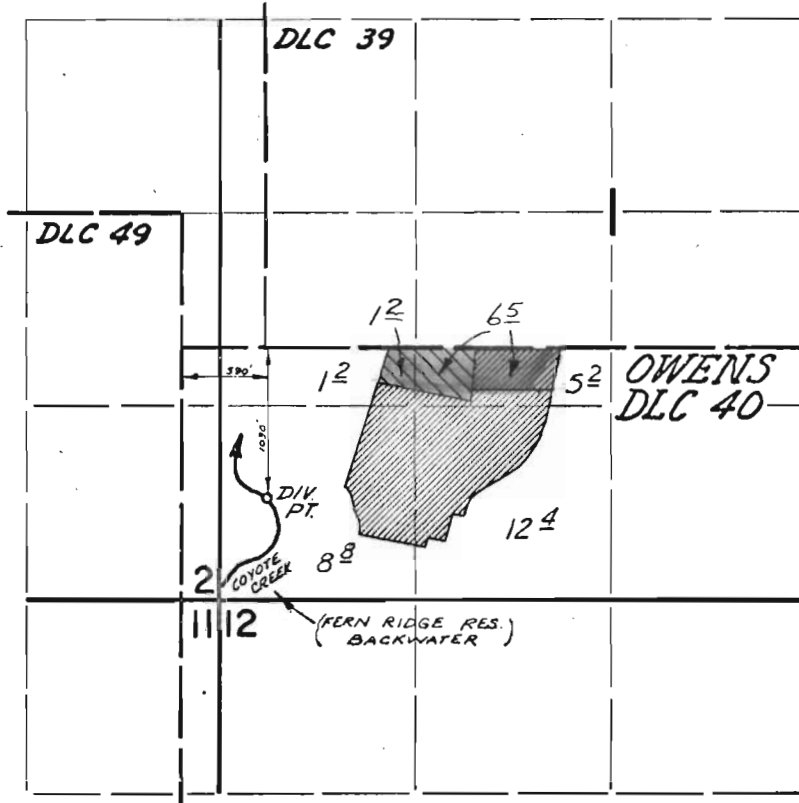

26  
13  
29

**FINAL PROOF SURVEY**  
UNDER

Application No. 44958 Permit No. 33603  
IN NAME OF

JAMES C. TAPP

Surveyed June 15, 1973, by D. Norby

Application No. 52809  
Permit No. 39858