


T16 & 17S. R5W. WM.

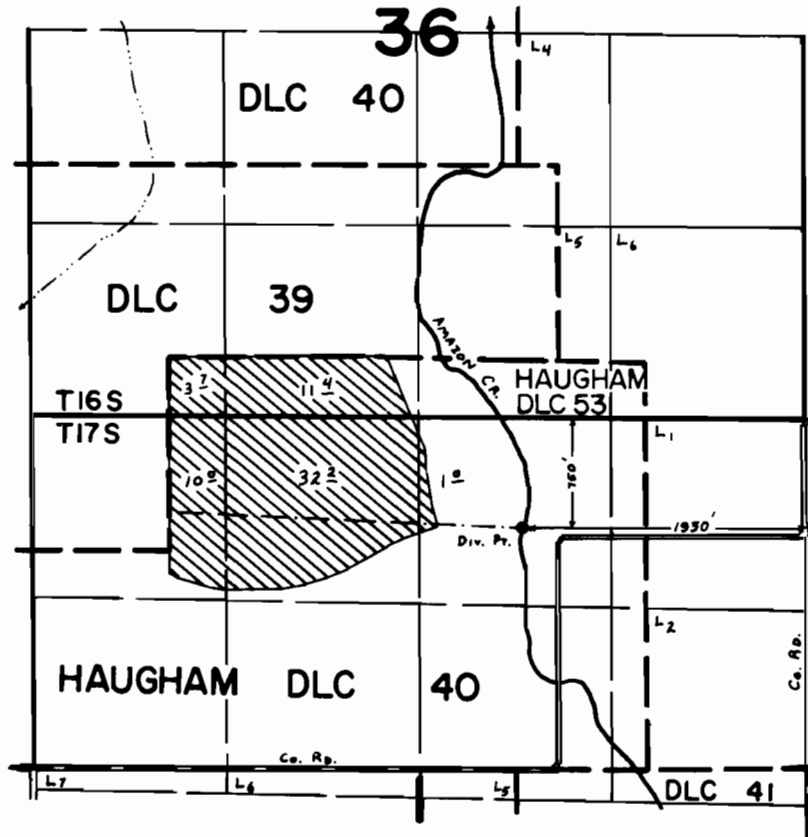

FINAL PROOF SURVEY UNDER

Application No. 54284 Permit No. 40650
IN NAME OF

HARLEY & CORETA CASE

Surveyed JUNE 15, 1978, by C. L. HUGHES