


T15S. R7W. WM.

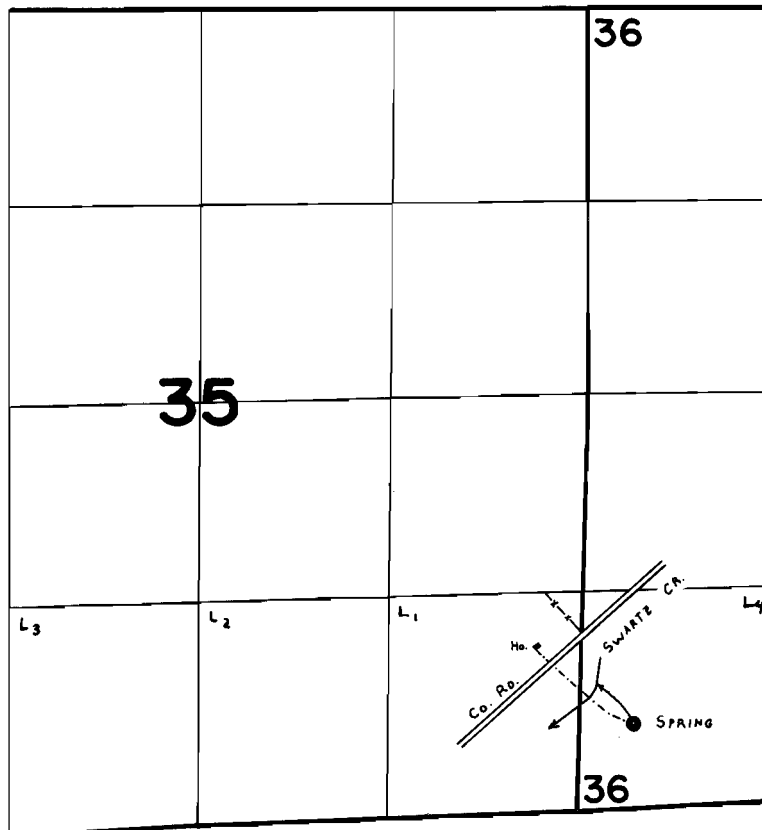

SPRING Loc : 600' N. & 380' E. fr. S.W. Cor. Sec. 36.

FINAL PROOF SURVEY
UNDER

Application No. 54492 Permit No. 40868
IN NAME OF

RAPHIEL EUGENE PATTERSON

Surveyed JUNE 13, 1978, by C. L. HUGHES