


T16S. R2E. WM.

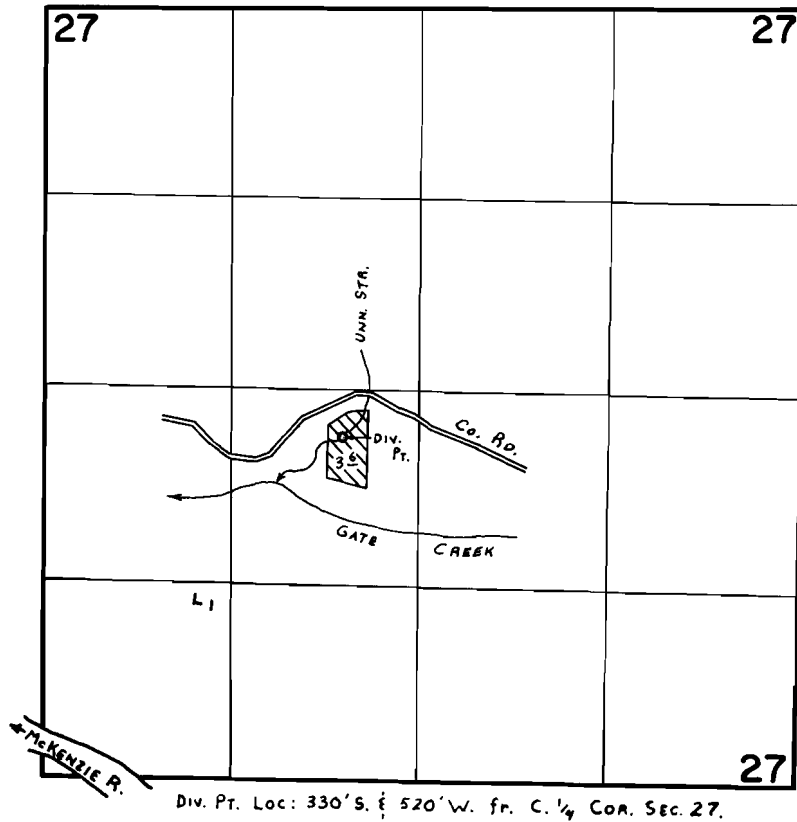

FINAL PROOF SURVEY UNDER

Application No. 54502 Permit No. 40876
IN NAME OF

HARLEY R. NORRIS, JR.

Surveyed MAY 25 1978, by C. L. HUGHES