


# T17S. RIW. WM.

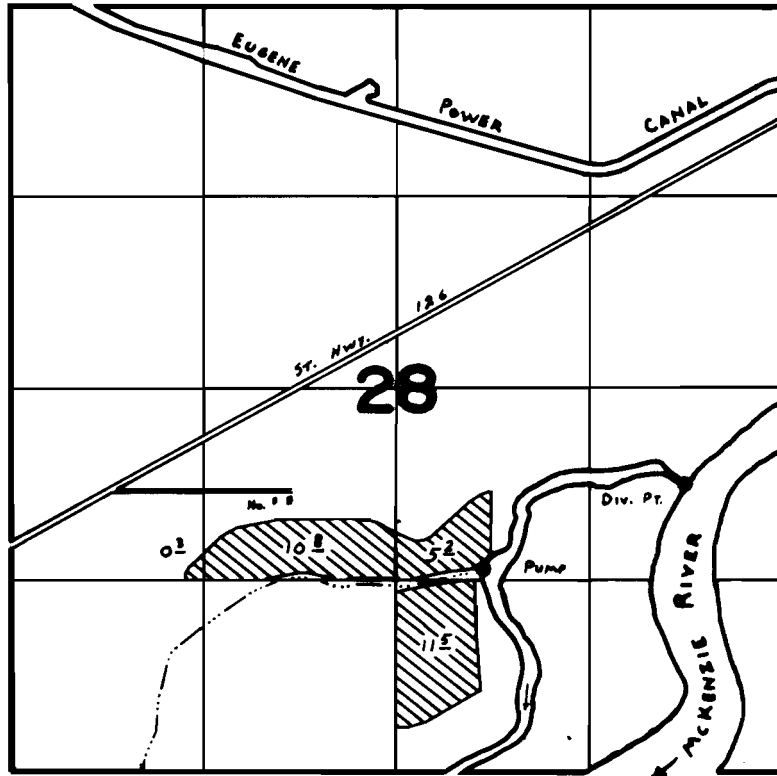

Div. Pt. Loc: 3280' S. { 660' W. }  
PUMP Loc: 3860' S. { 2030' W. } BOTH FROM N. E. Co. Sec. 28.

## FINAL PROOF SURVEY UNDER

Application No. 55130 Permit No. 41395  
IN NAME OF

JACK A. GRANT

Surveyed JULY 18, 1978, by C. L. HUGHES