


T18S. R11W. WM.

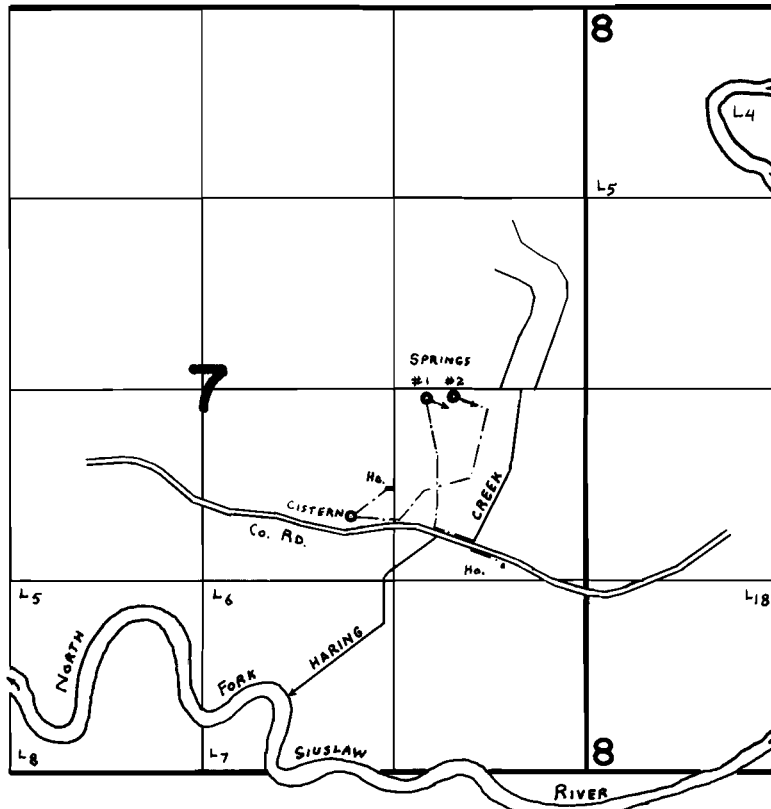

SPRINGS LOC: #1- 70'S. & 1090'W. } BOTH FROM E. 1/4 COR. SEC. 7.
#2- 60'S. & 910'W. }

FINAL PROOF SURVEY
UNDER

Application No. 56032 Permit No. 41946
IN NAME OF

BARBARA KAY McCURDY

Surveyed JULY 24 1978, by C. L. HUGHES