


T18S. R11W. WM.

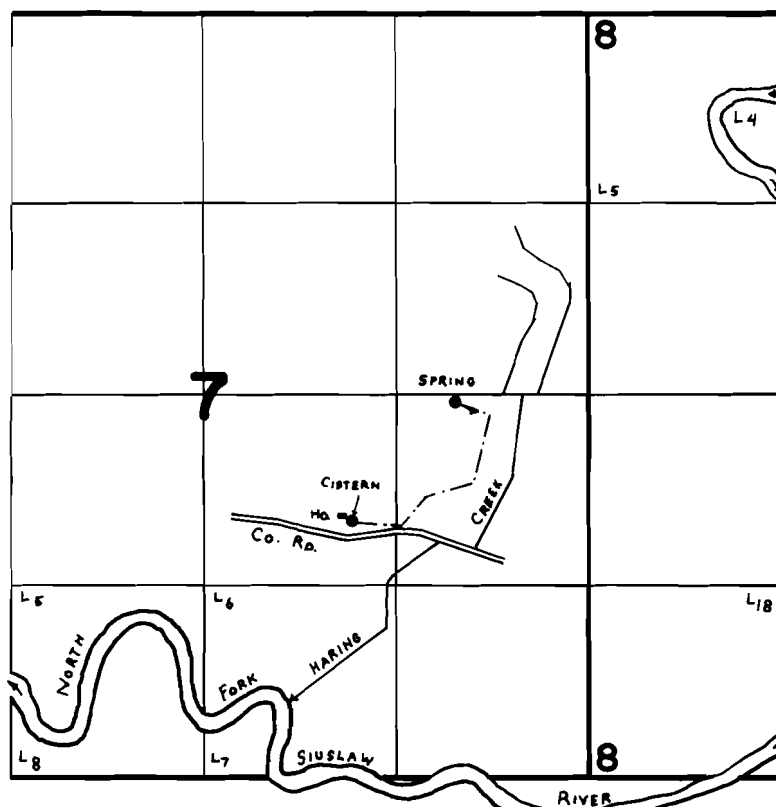

SPRING LOC: 60'S. E. 910' W. fr. E. $\frac{1}{4}$ COR. SEC. 7.

FINAL PROOF SURVEY UNDER

Application No. 56500 Permit No. 42230
IN NAME OF

FRED A. & EDNA STEERS

Surveyed JULY 24 1978, by C. L. HUGHES