


TIIS. R4W. WM.

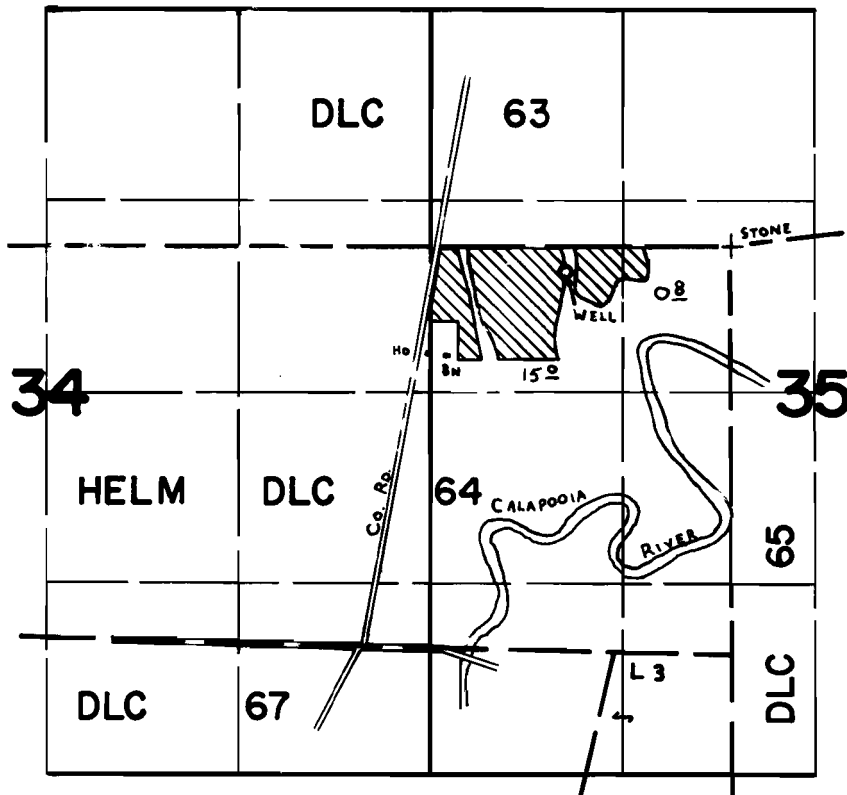

WELL LOC: 170'S & 1130'W fr. NE COR HELM DLC 64.

FINAL PROOF SURVEY UNDER

Application No. G-6552 Permit No. G-6156
IN NAME OF

GENE C. & LOENE C. BRONSON

Surveyed MAY 4 1978, by C. L. HUGHES