


T13S. R3E. WM.

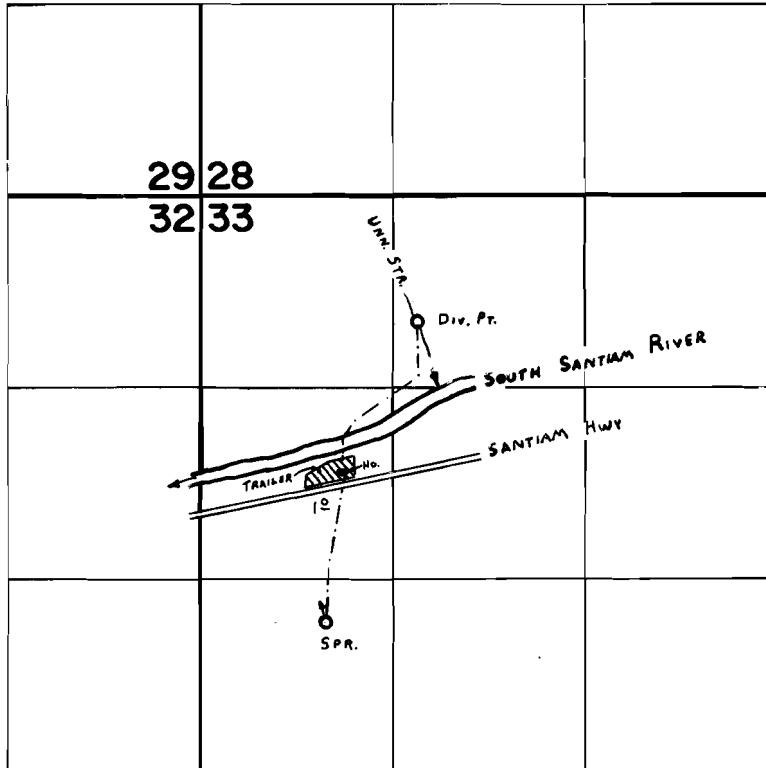

DIV. PT. LOC: 1760' N { 1470' E } BOTH FROM W 1/4 COR. SEC. 33.
SPR LOC: 300' S { 850' E }

FINAL PROOF SURVEY

UNDER

Application No. 48201 Permit No. 36204
IN NAME OF _____

FRANK & ORA STEENHOUT

Surveyed MAY 3 1978, by C. L. HUGHES