


# TIIS. R4W. WM.

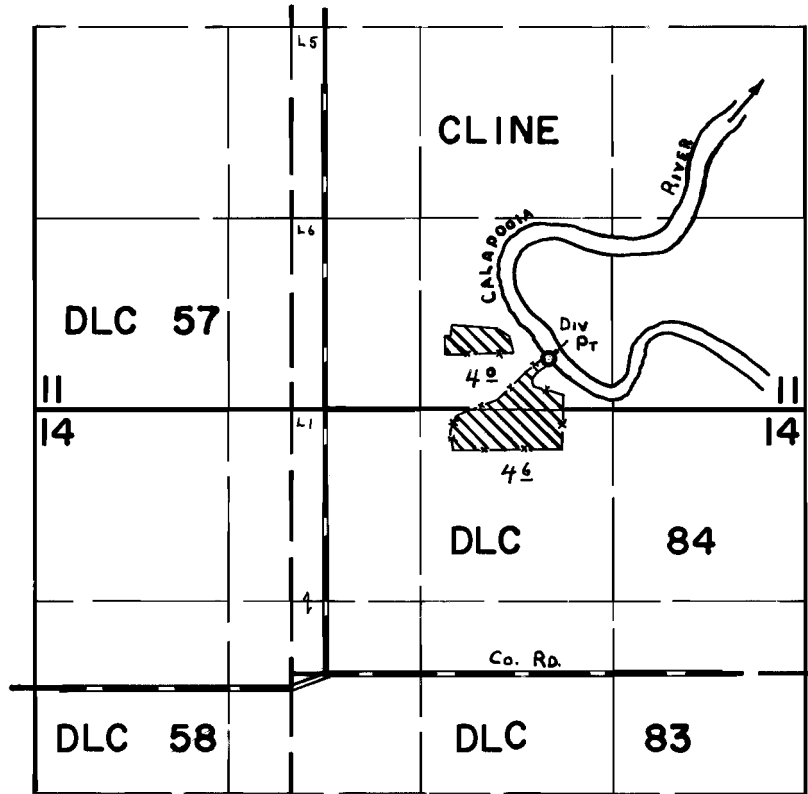

DIV. PT. Loc: 350' N & 870' E fr. S. 1/4 COR. SEC 11.

## FINAL PROOF SURVEY UNDER

Application No. 48266 Permit No. 36252  
IN NAME OF

LYLE D. SHIBLEY

Surveyed MAY 4 1978, by C. L. HUGHES