


# T7S. RIW. WM.

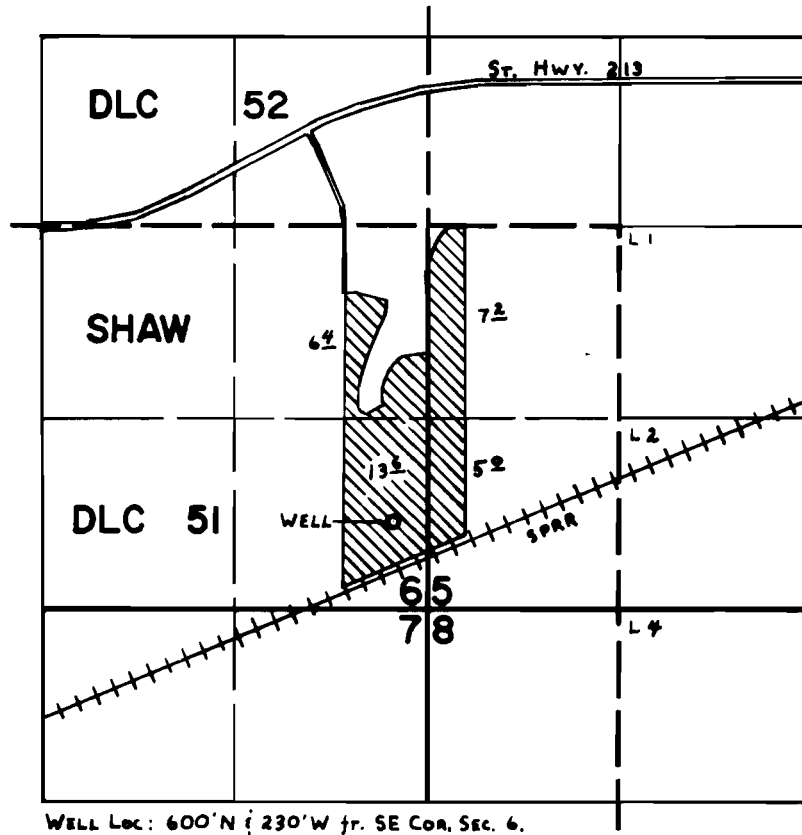

## FINAL PROOF SURVEY UNDER

Application No. G-5531 Permit No. G-5416  
IN NAME OF

HOWARD STANLEY EDWARDS

Surveyed MAY 18 1978, by C. L. HUGHES