


# TIS. R3E. WM.

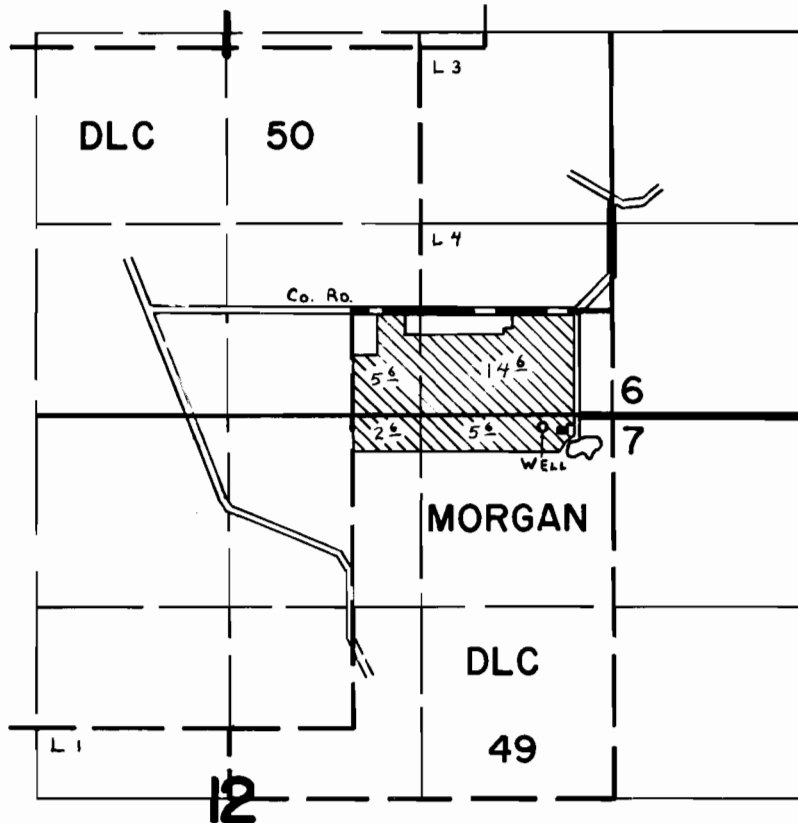

WELL Loc: 80'S & 480'W fr. NE COR Sec 12.

## FINAL PROOF SURVEY UNDER

Application No. G-7302 Permit No. G-6753  
IN NAME OF

ELMER M. STURM

Surveyed JUL. 11 1978, by C. L. HUGHES