


T2N. RIOW. WM.

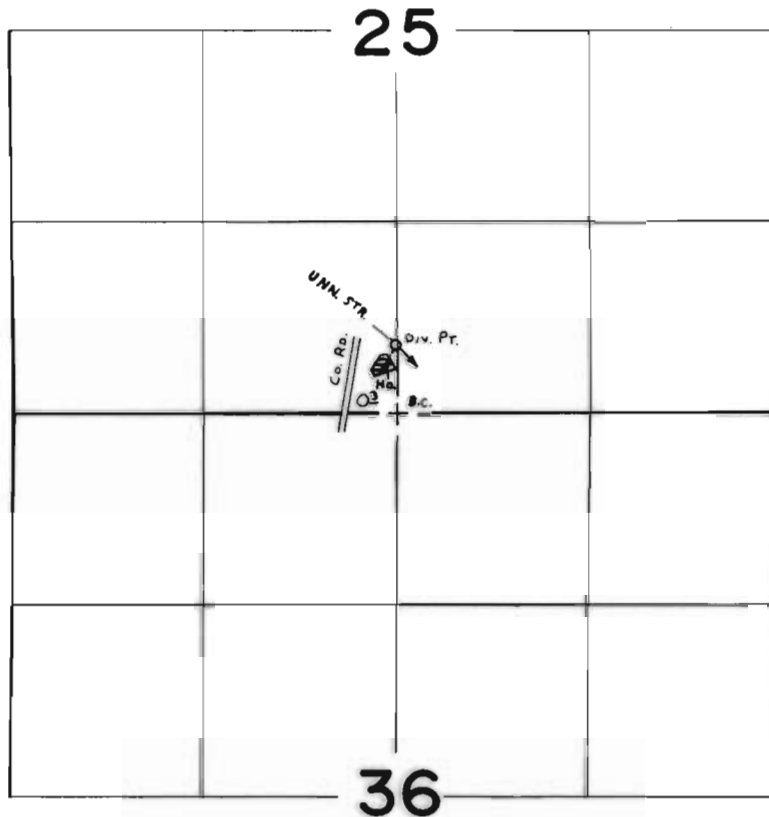

Div. Pt. Loc: 470' N E 20' W fr. S. $\frac{1}{4}$ Cor. Sec. 25.

FINAL PROOF SURVEY
UNDER

Application No. 49458 Permit No. 36705
IN NAME OF

HOWARD W. & DOROTHY D. MOEHNKE

Surveyed SEPT. 13 1978, by C. L. HUGHES