


T5S. R9W. WM.

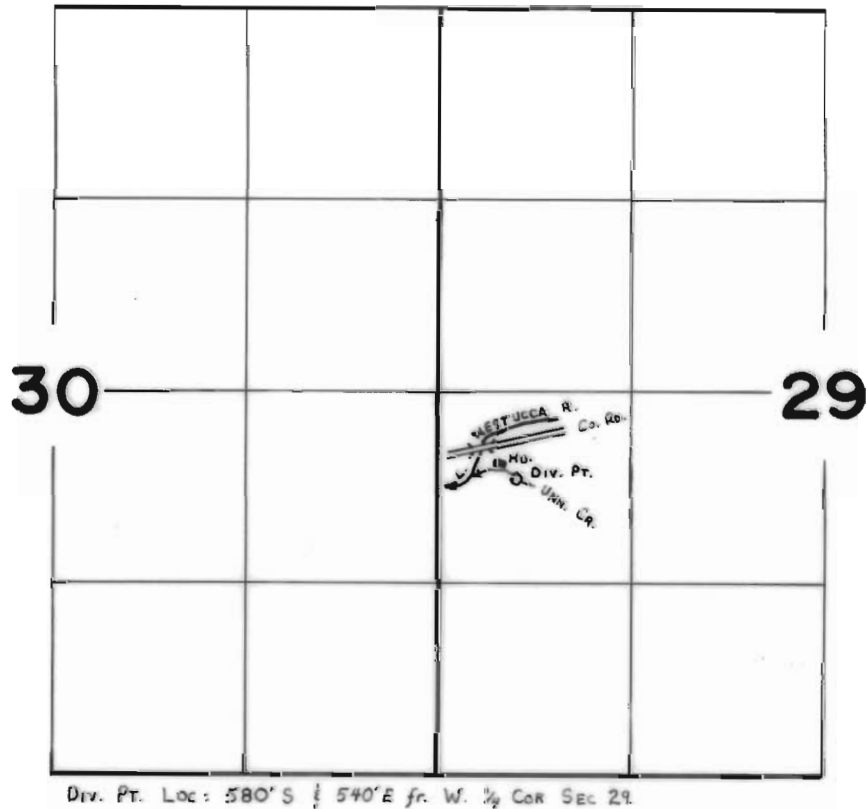

FINAL PROOF SURVEY
UNDER

Application No. 52839 Permit No. 39886
IN NAME OF

ORVILLE L. HOWE

Surveyed SEPT. 12 1978, by C. L. HUGHES