


T4S. RIOW. WM.

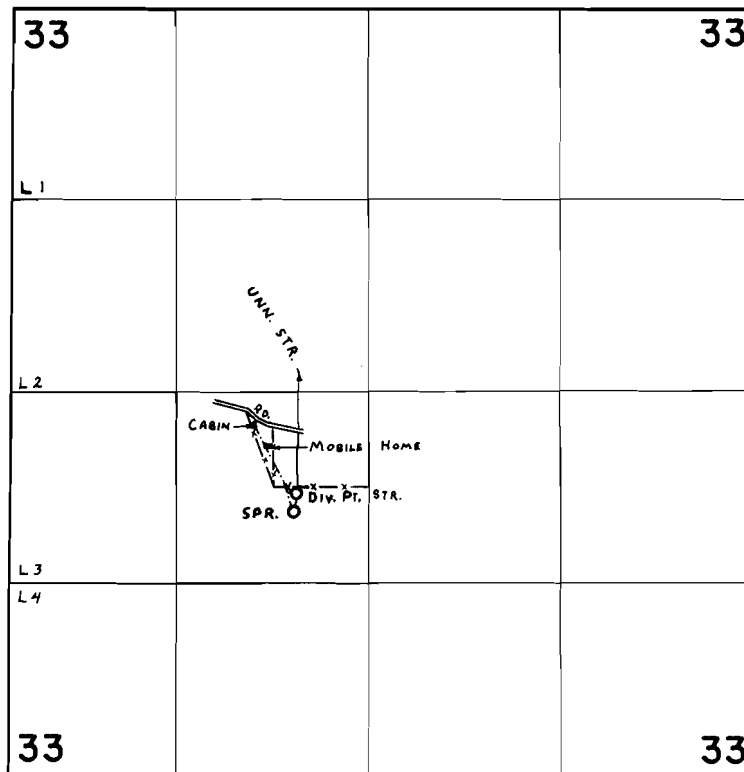

SPR. Loc: 810' S & 510' W
STR. DIV. PT. Loc: 690' S & 490' W } BOTH fr. CENTER 1/4 COR. SEC 33.

FINAL PROOF SURVEY
UNDER

Application No. 53126 Permit No. 40043
IN NAME OF

CLAY R. MAJHOR

Surveyed SEPT. 12 1978, by C. L. HUGHES