


TIS. R9W. WM.

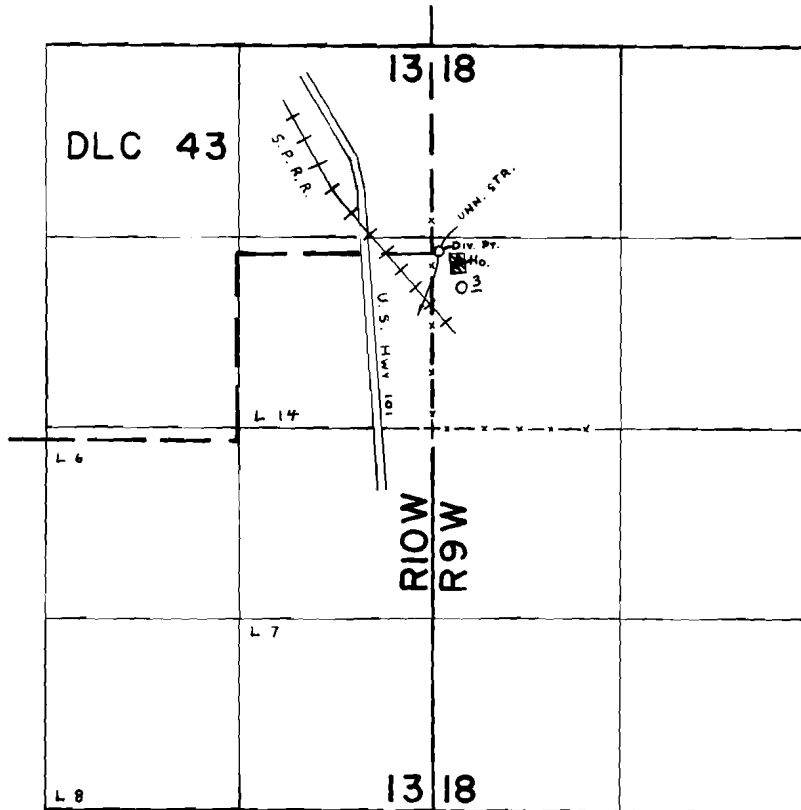

Div. Pt. Loc: 1220' N & 40' E fr. W $\frac{1}{4}$ Cor. Sec. 18.

FINAL PROOF SURVEY
UNDER

Application No. 57179 Permit No. 42984
IN NAME OF

ELDEN YEOMAN

Surveyed SEPT. 13 1978, by C. L. HUGHES