


T5S. R9W. WM.

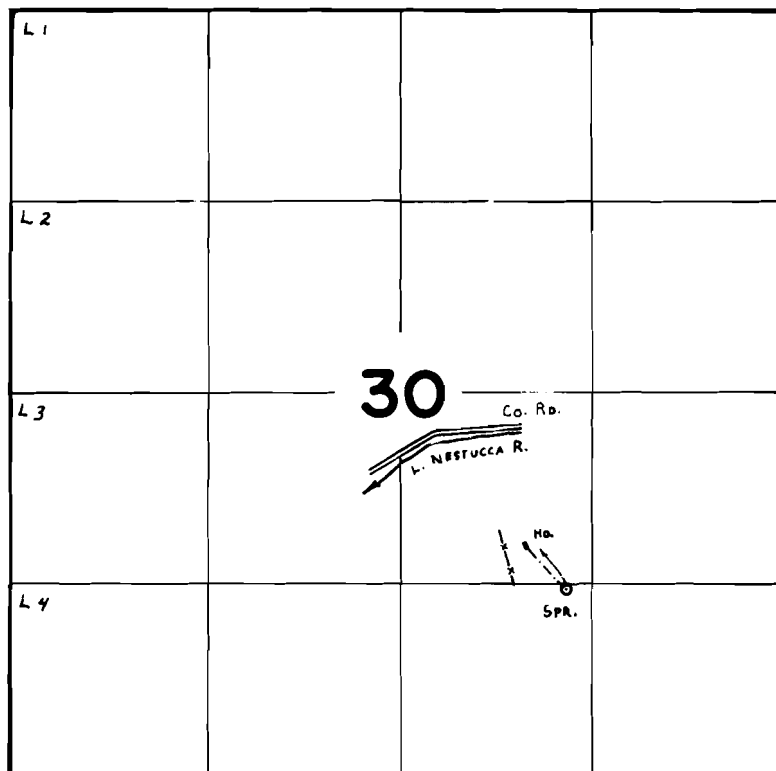

SPRING Loc: 1280' N & 1500' W fr. SE Cor. Sec 30.

**FINAL PROOF SURVEY
UNDER**

Application No. 57465 Permit No. 43236
IN NAME OF

ARTHUR JAMES COFFEY

Surveyed SEPT. 18, 1978, by C. L. HUGHES