


T2N. R5W. WM.

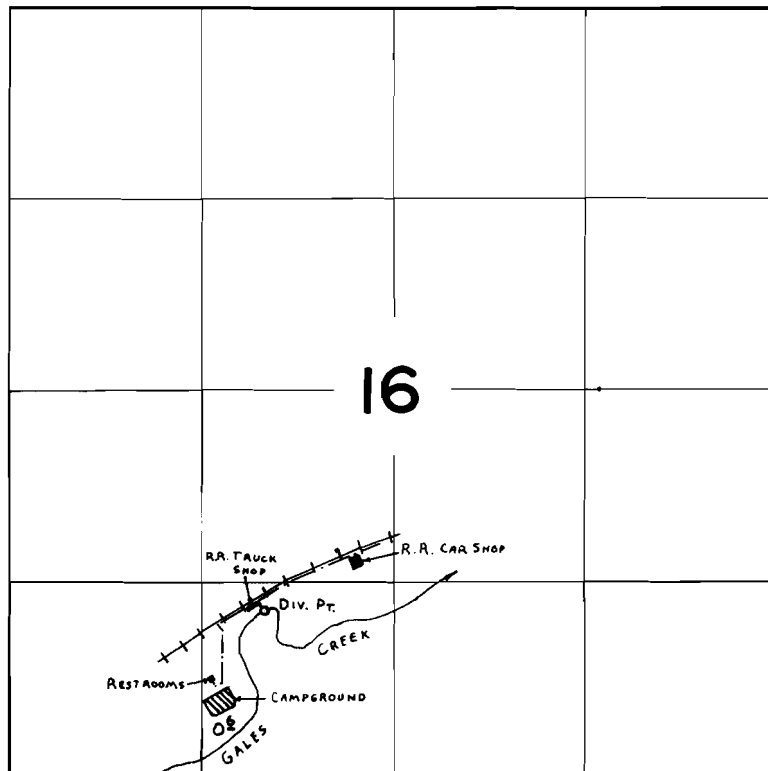

Div Pt Loc: 1120 N & 1750' E fr. SW Cor Sec 16.

**FINAL PROOF SURVEY**  
UNDER

Application No. 48297 Permit No. 36744  
IN NAME OF

PAUL V. CLASS

Surveyed AUG 10 1978, by C. L. HUGHES