


T2N. R5W. WM.

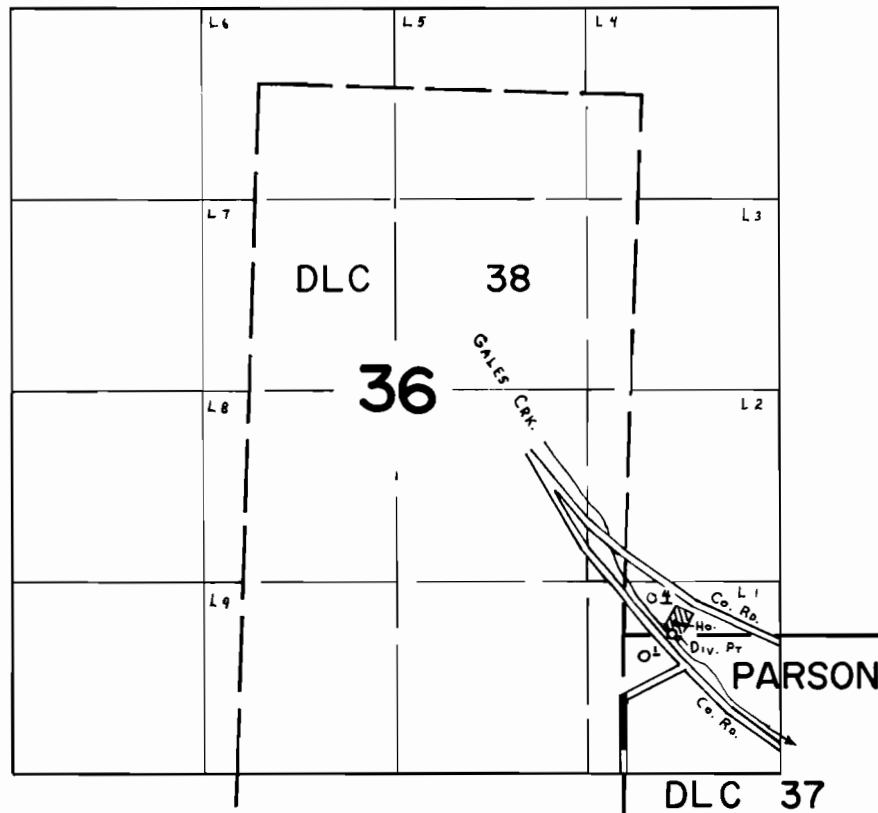

DIV. PT. LOC: 10' N & 330' E fr. NW COR PARSON DLC 37.

FINAL PROOF SURVEY
UNDER

Application No. 52249 Permit No. 37768
IN NAME OF

EUGENE C. KINDER

Surveyed AUG 10 1978, by C. L. HUGHES