


# T3S. R3W. WM.

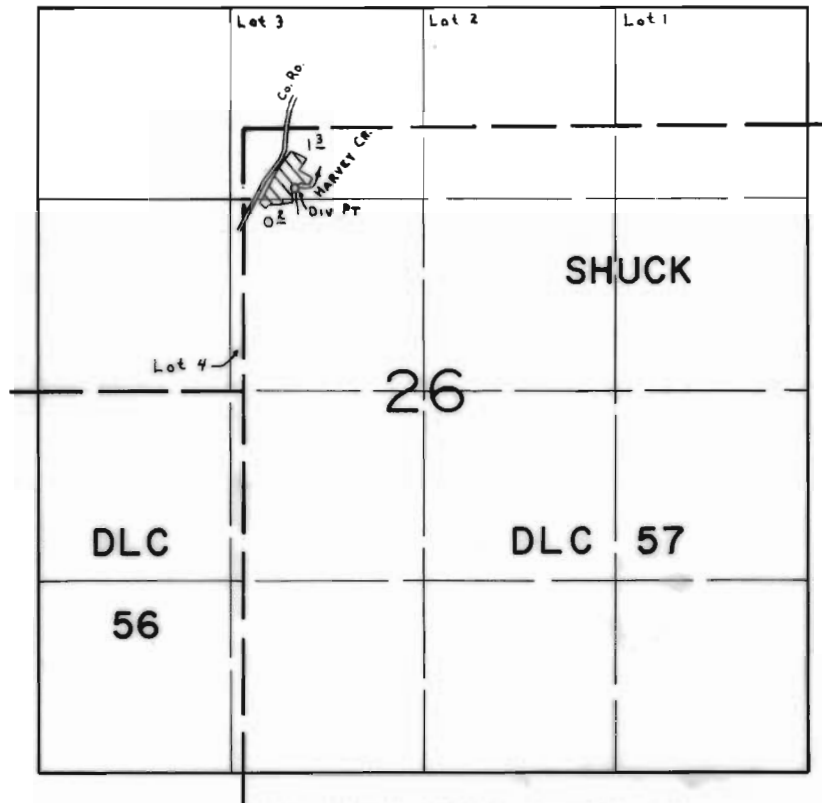

Div Pt Loc: 410' S. & 350' E. fr. NW Cor SHUCK DLC 57.

## FINAL PROOF SURVEY UNDER

Application No. 49384 Permit No. 37016  
IN NAME OF

EARL BARON

Surveyed OCT. 18, 1978, by C. L. HUGHES