


T5S. R6W. WM.

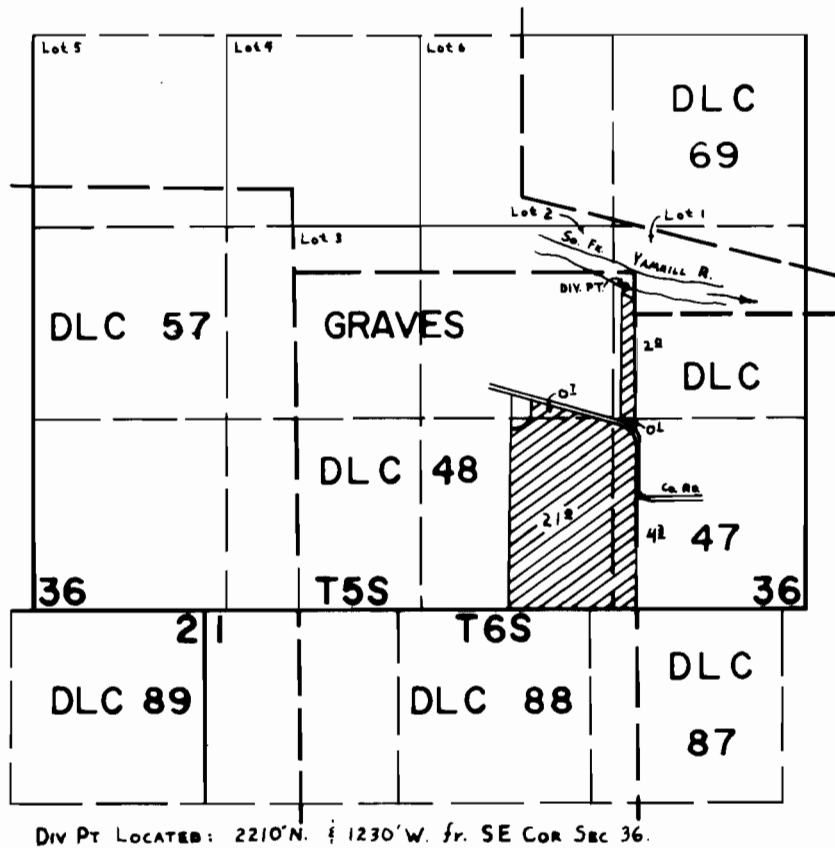

FINAL PROOF SURVEY UNDER

Application No. 54296 Permit No. 40721
IN NAME OF

MAXINE AND MYRON KADELL

Surveyed SEPT 6 1978, by C L HUGHES